

ITAWAMBA

MISSISSIPPI BOARD OF WATER COMMISSIONERS

G41
3-11-63

WATER WELL DRILLERS LOG

CODED

HERNDON WELL & SUPPLY CO.

Date March 11, 1963, Driller: SHANNON P. O. BOX 42 County ITAWAMBA
4 3 NO. 02 L MISSISSIPPI

	Description & Color of Materials Sand, Clay, Red Clay, Shell, etc.	Thick- ness Feet	Depth Feet
(1) Owner of Land: <u>Johnny Cantrell</u> (Name) <u>At 1, Dyer, Miss.</u> (Address) <u>2824210 SEWNE</u>	<u>surface soil</u> <u>5 clay</u> <u>8</u>		<u>0</u>
(2) Location: <u>1/4, 1/4, Sec. 10, T. 95.7N</u> <u>1/2</u> miles <u>SW</u> of <u>Watauga</u> (distance) (direction) (Nearest Town)	<u>Blue rock</u> <u>8</u>		<u>54</u>
(3) Topography: <u>Flat</u> (Hilly) (Flat) (Level)	<u>grnd</u> <u>5</u>		<u>65</u>
(4) Purpose of Well: <u>Domestic</u> (Domestic Irrigation Municipal, Industrial, Other)	<u>5</u>		<u>180</u>


Information upon completion of well:

- (1) Diameter 4 inches.
- (2) Total Depth 180 feet.
- (3) Water Level 30 feet below top of ground.
- (4) Cased to 96' 9", Size 4".
- (5) Screen: Size —, Length —.
- (6) Were any formations sealed against pollution?
yes, no.

If YES depth of formation 54 ft.

Why surface soil

Drillers Remarks:

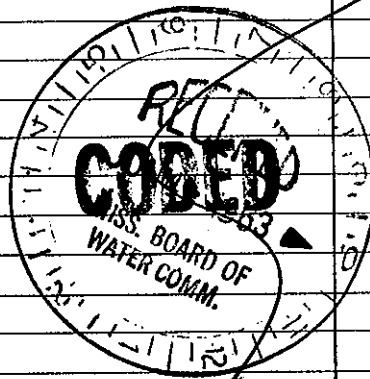

(Use Back Side)

Well No.

Mail this copy to Board of Water Commissioners 429 Miss. St. Jackson, Miss