

ITAWAMBA

MISSISSIPPI BOARD OF WATER COMMISSIONERS

CODED

G42

WATER WELL DRILLERS LOG

CODED

4-3-63

HERNDON WELL & SUPPLY CO.

Date: April 3, 1963, Driller: P.O. BOX 42 County: Itawamba

SHANNON, MISSISSIPPI

(1) Owner of Land: <u>James Smith</u> (Name)	Description & Color of Materials Sand, Clay, Red Clay, Shell, etc.	Thick- ness Feet	Depth Feet
#6 Dorsey, Miss SE NE (Address)	surface sand & clay		0
(2) Location: <u>1/4, 1/4, Sec 11, T. 95 N, R. 7 E</u> <u>3 1/2</u> miles <u>SW</u> of <u>Monticello</u> (distance) (direction) (Nearest Town)	blue rock	8	30
(3) Topography: <u>Flat</u> (Hilly) (Flat) (Level)	sand	8	38
(4) Purpose of Well: <u>Domestic</u> (Domestic Irrigation Municipal, Industrial, Other)	Bottom	150	150

Information upon completion of well:

(1) Diameter 4 inches.

(2) Total Depth 150 feet.

(3) Water Level 36 feet below top of ground.

(4) Cased to 24' 7", Size 4"

(5) Screen: Size _____, Length _____

(6) Were any formations sealed against pollution?


yes, _____ no.

If YES depth of formation 30'

Why surface & sand

Drillers Remarks:

CODED

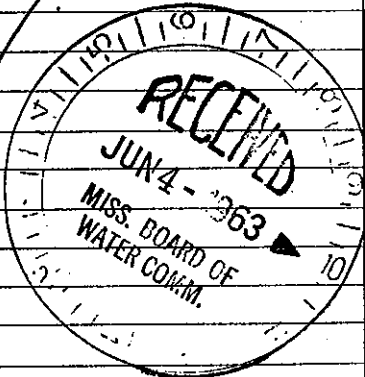

I 15

(Use Back Side)

Well No.

Mail this copy to Board of Water Commissioners 429 Miss. St. Jackson, Miss