

ITAWAMBA MISSISSIPPI BOARD OF WATER COMMISSIONERS

G 45
6-25-65

CODED

WATER WELL DRILLERS LOG

CODED

Date: June 2, 1965 Driller: Herndon-Homan Well & Supply, Inc. P. O. Box 42 County Itawamba
4 SHANNON, MISSISSIPPI 38868

(1) Owner of Land: LEE LINDSEY
(Name) Samuel White
PA 1, Dorsey, Miss
(Address)
(2) Location: SE 1/4, NW 1/4, Sec. 14 T 95 N R 7 E
3 miles SW, of Monticello
(distance) (direction) (Nearest Town)
(3) Topography: Hilly
(Hilly) (Flat) (Level)
(4) Purpose of Well: TRAILER
(Domestic Irrigation) (Municipal, Industrial, Other)

Description & Color of Materials Sand, Clay, Red Clay, Shell, etc.	Thick- ness Feet	Depth Feet
<u>Surface sand & clay</u>	<u>0</u>	<u>40</u>
<u>Blue clay</u>	<u>40</u>	<u>95</u>
<u>Small Cotton</u>	<u>95</u>	<u>220</u>
<u>Cotton</u>	<u>220</u>	


Information upon completion of well:

(1) Diameter 4 inches.
(2) Total Depth 220 feet.
(3) Water Level 123' feet below top of ground.
(4) Cased to 42' 3", Size 4"
(5) Screen: Size _____, Length _____
(6) Were any formations sealed against pollution?
 yes, _____ no.

If YES depth of formation 40'
Why Surface sand
Drillers Remarks:

I 18

CODED

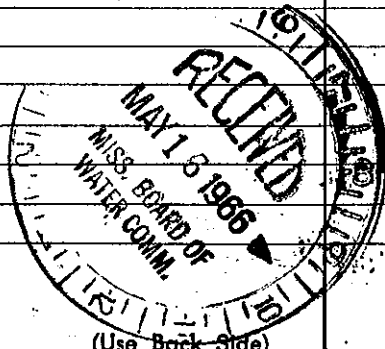

Well No.