

~~ITAWAMBA~~ MISSISSIPPI BOARD OF WATER COMMISSIONERS

~~G 46~~ CODED
6-27-62

WATER WELL DRILLERS LOG



CODED

ITAWAMBA

Date: 6-27, 1962, Driller: O. C. Webb Jr County: ITAWAMBA
4 (Name)

(1) Owner of Land:	Description & Color of Materials Sand, Clay, Red Clay, Shell, etc.	Thick- ness Feet	Depth Feet
Roy Farris (Name) Mooreville, Miss 8629229 (Address)	soil 6 ft lumps to 2.5 ft blue mud to 13.5 ft		
(2) Location: SW $\frac{1}{4}$, S W $\frac{1}{4}$, Sec. <u>27</u> T <u>9</u> R <u>7</u> , 2 miles East of Mooreville (distance) (direction) (Nearest Town)	Water Rock 6" Water sand to 200 ft		
(3) Topography: <u>K</u> (Hilly) (Flat) (Level)			
(4) Purpose of Well: <u>K</u> (Domestic Irrigation Municipal, Industrial, Other)	Red brick well		
Information upon completion of well:			
(1) Diameter <u>5</u> inches.			
(2) Total Depth <u>200</u> feet.			
(3) Water Level <u>95</u> feet below top of ground.			
(4) Cased to <u>30 ft</u> , Size <u>5"</u>			
(5) Screen: Size _____, Length _____			
(6) Were any formations sealed against pollution? _____ yes, _____ no.			
If YES depth of formation _____			
Why _____			
Drillers Remarks: _____			

171 ELEV 390			

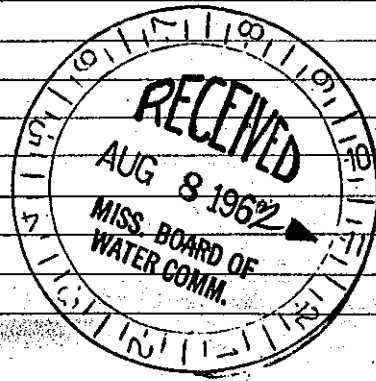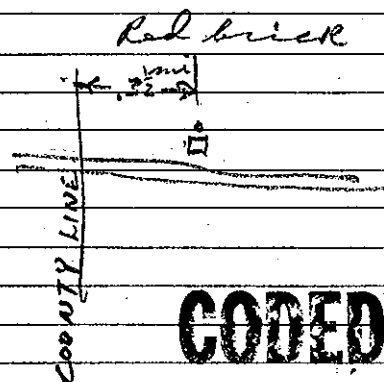

(Use Back Side)

Well No.

Mail this copy to Board of Water Commissioners 429 Miss. St. Jackson, Miss