

I tawamba
G48
5-66

MISSISSIPPI BOARD OF WATER COMMISSIONERS

CODED
CODED

WATER WELL DRILLERS LOG

Date: May 5, 1966, Driller: Herndon-Homan Well & Supply, Inc.
(When well drilled) P. O. Box 42, County Itawamba
SHANNON, MISSISSIPPI 38888 (Where well is located)

(1) Owner of Land: C. J. Hubbard
2824543 (Name)
At 1 Dorsey, Mississippi
(Address)
(2) Location: NW 1/4, SE 1/4, Sec. 14, T. 90 N, R. 17 E
3 miles SW of Monticello
(distance) (direction) (Nearest Town)
(3) Topography: Hilly
(Hilly) (Flat) (Level)
(4) Purpose of Well: Domestic
(Domestic Irrigation, Municipal, Industrial, Other)


Description & Color of Materials Sand, Clay, Red Clay, Shell, etc.	Thick- ness Feet	Depth Feet
<u>surface sand</u>		
<u>blue clay</u>		<u>0-30</u>
<u>blue clay</u>		<u>30-40</u>
<u>sand</u>		<u>40-200</u>
<u>bottom</u>		<u>200</u>

Information upon completion of well:

(1) Diameter 5 inches.
(2) Total Depth 200 feet.
(3) Water Level 40' feet below top of ground.
(4) Cased to 35', Size 54.
(5) Screen: Size none, Length —.
(6) Were any formations sealed against pollution?
— yes, — no.

If YES depth of formation 30'
Why surface sand
Drillers Remarks:
Yield in gpm: 5 GPM
Size pump: 1/2 HP Sub.
Type power: Electric

CODED

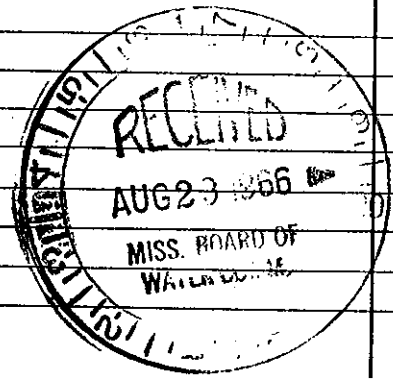

Mail this copy to Board of Water Commissioners 429 Miss. St. Jackson, Miss.