

I tawamba
G 49
6-66

MISSISSIPPI BOARD OF WATER COMMISSIONERS

CODED


WATER WELL DRILLERS LOG

CODED

Herndon-Horman Well & Supply, Inc.

Date: JUNE 4, 1966, Driller: BLANNON, MISSISSIPPI County: I tawamba
(When well drilled) (Name) (Where well is located)

(1) Owner of Land 2824547 <u>Elbert Fielder</u> (Name)	Description & Color of Materials Sand, Clay, Red Clay, Shell, etc.	Thick- ness Feet	Depth Feet
<u>PT 1 DOBSON, MISS.</u> (Address)	<u>topsoil</u>		
(2) Location: <u>SE 1/4, NW 1/4, Sec 14, T 95 N, R 14 E</u>	<u>red clay</u>	<u>0-35</u>	
<u>3/4 miles NE of Meridian</u> (distance) (direction) (Nearest Town)	<u>blue clay</u>	<u>35-190</u>	
(3) Topography: <u>Hills</u> (Hilly) (Flat) (Level)	<u>gravel</u>	<u>190-220</u>	
(4) Purpose of Well: <u>Domestic</u> (Domestic irrigation, Municipal, Industrial, Other)	<u>bottom</u>	<u>220</u>	

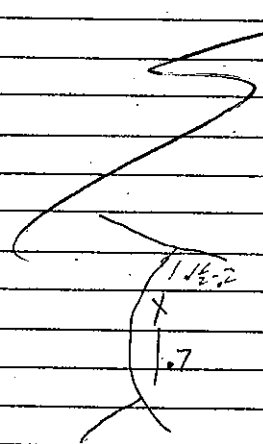

Information upon completion of well:

- (1) Diameter 5 inches.
- (2) Total Depth 220 feet.
- (3) Water Level 123' feet below top of ground.
- (4) Cased to 39 5/8", Size 5"
- (5) Screen: Size none, Length —
- (6) Were any formations sealed against pollution?
yes, no.

If YES depth of formation 35'

Why surface + sand


Drillers Remarks: —

Yield in gpm: 5 gpm

Size pump: 1/3 HP Sub

Type power: Electric

CODED

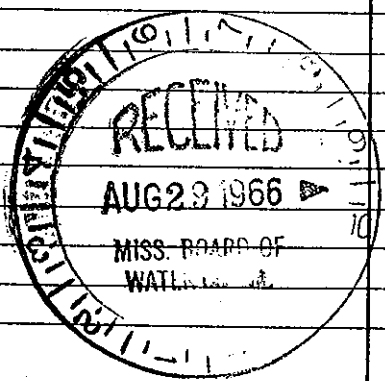

Mail this copy to Board of Water Commissioners 429 Miss. St. Jackson, Miss.