

ITAWAMBA

MISSISSIPPI BOARD OF WATER COMMISSIONERS

657

CODED

WATER WELL DRILLERS LOG

CODED

4-2-63

HERNDON WELL & SUPPLY CO.

Date April 2, 1963, Driller: P.O. BOX 42 County Itawamba

4 LAS AR BOROP + SHANNON, MISSISSIPPI

(1) Owner of Land: <u>Belbert Sheffield</u> <small>(Name)</small>	Description & Color of Materials Sand, Clay, Red Clay, Shell, etc.	Thick- ness Feet	Depth Feet
<u>2822836 N.E.</u> <u>2823355 W.E.</u> <u>Dorsey, Miss.</u> <small>(Address)</small>	<u>surface sand</u> <u>+ clay</u>		<u>0</u>
(2) Location: <u>SW SW SW</u> <u>1/4, of 1/4, Sec 31, T 23 N, R 3 E</u>	<u>Blue rock</u>		<u>20</u>
miles <u>—</u> of <u>Dorsey</u> , <small>(distance) (direction) (Nearest Town)</small>	<u>8</u>		
(3) Topography: <u>Hills</u> <small>(Hilly) (Flat) (Level)</small>	<u>sand</u>		<u>120</u>
(4) Purpose of Well: <u>Domestic</u> <small>(Domestic Irrigation Municipal, Industrial, Other)</small>	<u>8</u> <u>Bottom</u>		<u>136</u>

Information upon completion of well:


- (1) Diameter 4 inches.
- (2) Total Depth 136 feet.
- (3) Water Level 90 feet below top of ground.
- (4) Cased to 131', Size 4".
- (5) Screen: Size 4", Length 5'.
- (6) Were any formations sealed against pollution?
— yes, — no.

If YES depth of formation 2'

Why surface & sand

Drillers Remarks:

CODED

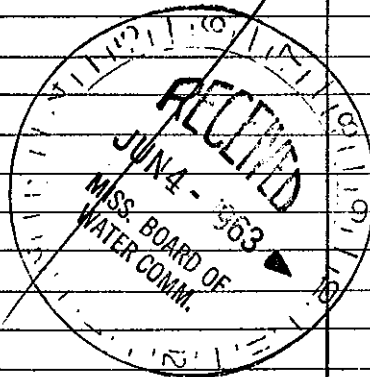

Itawamba

(Use Back Side)

Well No.

I 14

Mail this copy to Board of Water Commissioners 429 Miss. St. Jackson, Miss.