

ITAWAMBA MISSISSIPPI BOARD OF WATER COMMISSIONERS

G58

CODED

CODED

4-3-62

WATER WELL DRILLERS LOG

Date: April 2, 1962, Driller: HERNDON WELL & SUPPLY CO. County: Itawamba


P. O. BOX 42
SHANNON, MISSISSIPPI

(1) Owner of Land:	Description & Color of Materials Sand, Clay, Red Clay, Shell, etc.	Thick- ness Feet	Depth Feet
P. A. Martin (Name)	sand & clay		0
Dorsey, Mississippi (Address)			
Location: N 1/4, S W 1/4, Sec. 31, T. 4 N., R. 4 E.	Blue sand		30
_____ miles _____ of Dorsey (distance) (direction) (Nearest Town)	sand		60
(3) Topography: Hilly (Hilly) (Flat) (Level)	Bottom		180
(4) Purpose of Well: Domestic (Domestic Irrigation Municipal, Industrial, Other)			

Information upon completion of well:

- (1) Diameter: 4 inches.
- (2) Total Depth: 180 feet.
- (3) Water Level: 30 feet below top of ground.
- (4) Cased to: 36', Size 4"
- (5) Screen: Size _____, Length _____
- (6) Were any formations sealed against pollution?
 yes, _____ no.
- If YES, depth of formation: 30
- Why: Super sand
- Drillers Remarks: in Dorsey

CODED

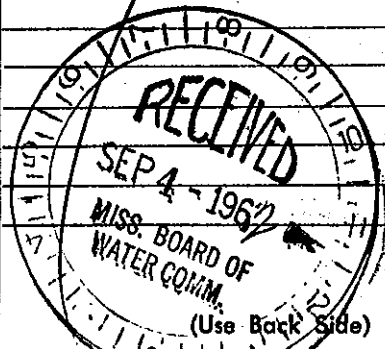

Well No.

Mail this copy to Board of Water Commissioners, 429 Miss. St. Jackson, Miss.