

WATER WELL DRILLERS LOG

Date: 6/30, 1966, Driller: C. Williams County: Stawamba

ON 78 ON RT 25. RT

(1) Owner of Land:	Description & Color of Materials Sand, Clay, Red Clay, Shell, etc.	Thick- ness Feet	Depth Feet
<u>8229097</u> <u>C. R. Killentine</u> (Name) <u>Dorsey</u> (Address)	<u>Joint Clay</u>	<u>0</u>	<u>50</u>
(2) Location: <u>SW NE NW</u> <u>1/4, 1/4, Sec 36</u> <u>95.7E</u> <u>TR</u>	<u>Blue</u>	<u>50</u>	<u>70</u>
<u>1</u> miles <u>W</u> of <u>Dorsey</u> (distance) (direction) (Nearest Town)	<u>Sand</u>	<u>70</u>	<u>152</u>
(3) Topography: <u>Hilly</u> (Hilly) (Flat) (Level)			
(4) Purpose of Well: <u>Domestic</u> (Domestic Irrigation Municipal, Industrial, Other)	<u>78</u>		


Information upon completion of well:

- (1) Diameter 5 inches.
- (2) Total Depth 152 feet.
- (3) Water Level 13 feet below top of ground.
- (4) Cased to 55 ft., Size 5 in.
- (5) Screen: Size _____, Length _____.
- (6) Were any formations sealed against pollution?
_____ yes, _____ no.

If YES depth of formation _____

Why _____

Drillers Remarks: _____

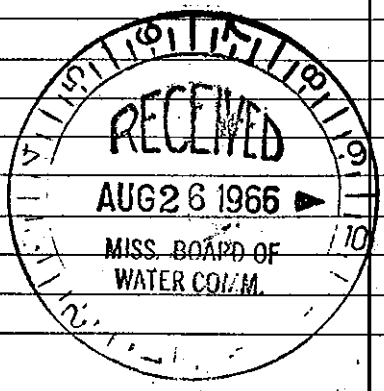

(Use Back Side)

Well No