

MISSISSIPPI DEPARTMENT OF ENVIRONMENTAL QUALITY
Bureau of Land and Water Resources

P. O. Box 10631
Jackson, MS 39289-0631
WATER WELL DRILLERS LOG

COUNTY WELL LOCATED I TAWAMBA		PERMIT NUMBER
WELL NUMBER 2006	CODED	NAME OF DRILLING FIRM KEEPEL Drilling
DATE WELL COMPLETED FEB 1993		LOW TO TIC

NAME & MAILING ADDRESS OF LANDOWNER
LANCE BEAN
RT 1
Manachie MS

WELL LOCATION: SEC **7** TOWNSHIP **9^N 8^W** RANGE **8^E**

DISTANCE **3** Miles DIRECTION **SW** NEAREST TOWN **of MANACHIE**

OTHER LANDMARK
FAWN GROVE Community
Hog Barn

WELL PURPOSE: Home, Irrigation, Municipal, Industrial, Fish Pond, etc.

PUMP DATA

PUMP TYPE (Circle One):
 Submersible, Turbine, Jet, Flowing Well,
Other (Describe) _____

POWER TYPE (Circle One):
 Electric, Tractor, Diesel, Gasoline, Butane,
Other (Describe) _____ H/P _____

Pump Capacity (GPM)	No. of Stages	Setting Depth
10	12	140 FT.

PUMP TEST
Well yielded _____ GPM with
a drawdown of _____ ft.
after _____ hours of pumping

WELL DATA

Well Depth 180'	Casing Diameter (In.) 4"	Casing Length (Ft.) 165'
Type of Casing PVC	Hole Depth 180'	Depth to Static Water Level 90'

TYPE OF COMPLETION: (Circle One or More):
 Gravel Packed, Underreamed, Telescoped,
 Natural Development, Open Hole, Other
(Describe) _____

Top of Lap Pipe or Reduction in Casing
FEET IF TELESCOPED OR MORE THAN ONE SCREEN: USE BACK PAGE

LOG DATA

TYPE OF LOG RUN (Circle One):
 No Log Run, Electric, Gamma Ray, Density, Sonic, Neutron,
Other (Describe) _____

Name of Organization Running Log

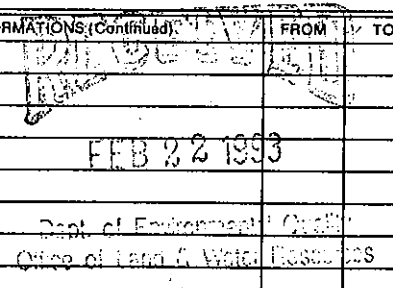
SCREEN DATA

Diameter - Inches 4"	Length - Feet 15'	Slot Size - Inches .010
Screen Type SLOTTED PVC	Depth to Bottom - Feet 180'	

GEOLOGIC DATA (Office Use Only)

Surface Elev.	Geologic Unit	Unit Thickness	Depth to Top
Subs. SWL	Date	Analysis	Aquifer Test

Driller's Remarks

DESCRIPTION OF FORMATIONS ENCOUNTERED	FROM	TO	FORMATIONS (Continued)	FROM	TO
TOP CLAY	0	20			
Blue clay	20	60			
Blue clay Silt sand	and				
clay	60	160			
White sand	160	180			

IF MORE SPACE IS NEEDED, USE BACK