

MISSISSIPPI BOARD OF WATER COMMISSIONERS

ITAWAMBA CODED

HB

WATER WELL DRILLERS LOG

CODED

10-19-60

Date: 10-19, 1960, Driller: Ewing Gas Co. County Lee

4

Name

(1) Owner of Land	Description & Color of Materials Sand, Clay, Red Clay, Shell, etc.	Thick- ness Feet	Depth Feet
E. W. Riley Lumber Co. (Name) Fulton, Miss. (Address)			
(2) Location: NE 1/4, NE 1/4, Sec. 35 T9R7 miles _____ of _____ (distance) (direction) (Nearest Town)			
(3) Topography: _____ (Hilly) (Flat) (Level)			
(4) Purpose of Well: Domestic (Domestic Irrigation Municipal, Industrial, Other)			

CODED

Information upon completion of well:

(1) Diameter 4 inches.

(2) Total Depth 185 feet.

(3) Water Level 80 feet below top of ground.

(4) Cased to 23' Size _____


(5) Screen: Size _____, Length _____

(6) Were any formations sealed against pollution?
 yes, _____ no.

If YES depth of formation 23'

Why _____

Drillers Remarks: _____

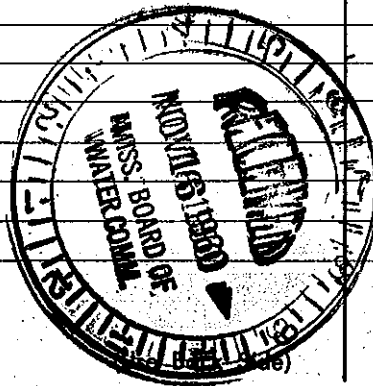

Well No.

Mail this copy to Board of Water Commissioners 429 Miss. St. Jackson, Miss.