

Stowamba  
H 16  
6-22-81

MISSISSIPPI DEPARTMENT OF NATURAL RESOURCES

Bureau of Land and Water Resources

Southport Mall

P.O. Box 10631

Jackson, Mississippi 39209

WATER WELL DRILLERS LOG

CODED

6-22-81 *Gamer Drilling Service, Inc* *Stowamba*  
date well completed firm name county well located

LANDOWNER:	description of formations encountered	from	to
<i>Betty Oil Corporation</i>	<i>Top soil - fill</i>	<i>0</i>	<i>21</i>
<i>P.O. Box 16809</i>	<i>rock, sand</i>	<i>21</i>	<i>252</i>
<i>Mobile, Ala. 36616</i> (mailing address)	<i>rock</i>	<i>252</i>	<i>430</i>

#1 sec 6 T 9 N R 9 of  
*Owner*  
*Deacon North of Fulton*  
6-10  
(distance) (direction) (nearest town)


WELL LOCATION: *1350' N of 1550' W*

WELL PURPOSE: *oil field supply*  
(home, irrigation, municipal, industrial)

WELL COMPLETION DATA:

- (1) diameter (inches) 3"
- (2) total depth (feet) 430'
- (3) static water level (feet) 90' below top of ground
- (4) casing Steel 252' (material) (depth)  
3" (size) if telescope see back.
- (5) screen 42' 210' (length) (depth to top)  
3" perforated (size) (material)
- (6) pump — (HP) 60 (yield gpm)  
ac (type power)
- (7) electric log — (yes or no)  
(organization running log)
- (8) how well bottom plugged range  
peel

CODED

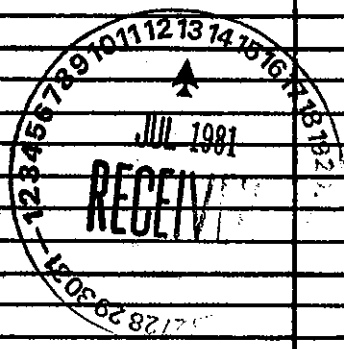

DRILLERS REMARKS: