

# STATE WELL REPORT

## Part 1

### Driller's Log

Mississippi Department of Environmental Quality  
Office of Land and Water Resources  
P.O. Box 2309  
Jackson, MS 39225-2309  
(601)961-5210  
(601)360-0535 (fax)

#### For Office Use Only:

Well #: \_\_\_\_\_  
Aquifer: J24  
E-Log #: \_\_\_\_\_

County: ~~Monroe~~ Iteumbwa  
Permit #: \_\_\_\_\_  
Driller: Thomas Rossi #0509  
Date drilling completed: 2-11-2013

*State Law requires that this report be prepared by the license holder responsible for the work and filed with the Department at the above address within 30 days of completion of drilling of the well or borehole.*

Well Owner Information <i>(Landowner if borehole is not for a water well)</i>	Well or Borehole Location
Owner Name: <u>Jonathan Black</u>	Latitude: <u>34°16'43.4604"</u> Longitude: <u>-88°15'4.918"</u>
Mailing Address: <u>448 Wilson Yielding Rd.</u>	Method of Lat/Long (check one): Conventional Survey _____, <sup>43</sup> <sup>0's</sup>
<u>Fulton</u> MS 38842	USGS quad _____, Hand-held GPS _____, Survey-grade GPS _____
City State Zip Code	<u>N 1/4</u> <u>E 1/4</u> , Sec <u>28</u> <input checked="" type="checkbox"/> T <u>9</u> S <u>R 10</u> E
Telephone No. <u>(662) 610-9134</u>	<u>7</u> Miles <u>North</u> of <u>Tremont</u> (Distance) (Direction) (Nearest Town)

Well / Borehole Data
Date drilling started: <u>02-07-2013</u> Date drilling completed: <u>02-11-2013</u> Hole depth: <u>175</u> Hole diameter: <u>4</u>
Location of the source of any surface water used for drilling: _____
Method of dosing and volume of Chlorine used in drilling and development: _____
Logs run (circle all applicable): ( <u>No log run</u> ) Electric Gamma Ray Density Sonic Neutron Other: _____
Name of organization running log(s): _____
Purpose of borehole (circle one): ( <u>Water Well</u> ) Geotechnical/Geological Investigation Ground Source Heat Pump Seismic Survey Other (describe) _____
<i>If drilling is not related to water well construction, skip the remainder of this block</i>
Purpose of Well (circle all applicable): ( <u>Home</u> ) Industrial Public Supply Irrigation Fish Culture
Other (describe): _____
If a flowing well, method of flow regulation: Valve _____ Other (describe) _____
Static Water Level: <u>135</u> feet [above or ( <u>below</u> ) ] land surface Date measured: _____ (circle one)
Method of measurement (circle one): ( <u>Steel tape</u> ) Electric tape Air line Other (describe): _____
Well depth: <u>175</u> Well grouted to a depth of: <u>10</u> feet Type of grout (circle one): ( <u>Neat Cement</u> ) <del>Bentonite</del> <del>Mix</del>
Casing length: <u>165</u> feet Casing diameter: <u>4</u> inches Type of casing: <u>PVC</u>
Screen length: <u>10</u> feet Screen diameter: <u>4</u> inches Type of screen: <u>PVC</u>
Screen slot size: <u>010</u> inches Setting depth: From <u>165</u> feet to <u>175</u> feet
Type of completion (circle all applicable): ( <u>Gravel packed</u> ) Underreamed Open hole Natural Development
Other (describe): _____
Top of lap pipe or reduction in casing: _____ feet


*If telescoped or more than one screen, describe on next page*

County: Monroe  
 Permit #: \_\_\_\_\_

**For Office Use Only:**  
 Well #: J24

**The sketch below only required for water wells**

**If well telescopes, show depths on sketch.**

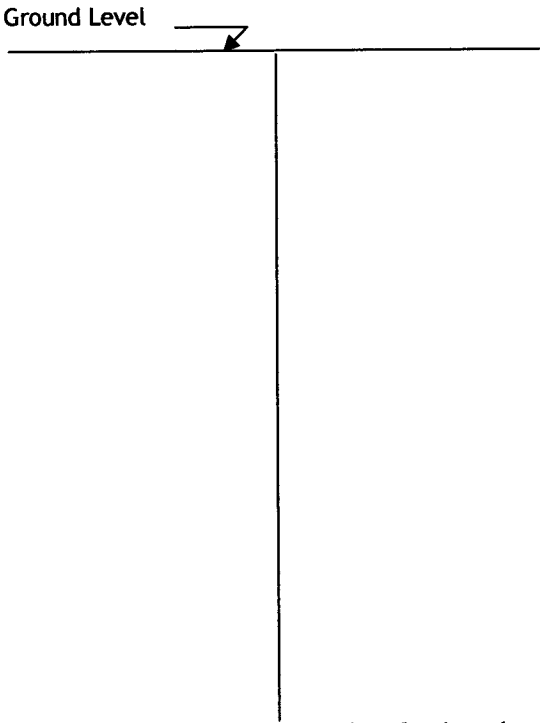

**Description of formations encountered must be provided for all wells and boreholes, unless specifically exempted by regulations**

Description of Formations Encountered	From (depth) Ground level	To (depth)
Clay	0	20
Rock	20	22
Clay	22	40
Clay	40	60
Clay	60	80
Clay	80	85
Rock	85	88
Clay	88	100
Clay	100	115
Rock	115	117
Clay	117	120
Clay	120	123
Sand Strip	123	127
Clay	127	130
Rock	130	135
Clay	135	140
Clay	140	155
Sand	155	160
Sand & Gravel	160	175

If more than one screen, show location of each on sketch

Sketch the property layout and include the following:

- 1) the well location
- 2) any permanent structures on the property that may aid in locating the well
- 3) any roads, power lines, or other items that may aid in locating the property and the well
- 4) north arrow

RECEIVED  
 MAY 20 2013  
 BY: OLWR

Jonathan Black

Landowner Name: \_\_\_\_\_

I HEREBY CERTIFY that the well/borehole was drilled, constructed, and completed in accordance with all applicable requirements of the Mississippi Department of Environmental Quality and the Mississippi Department of Health regulations, if applicable, and state laws.

Thomas Rossi


#0509

05-13-2013

Print Name of Responsible Licensee and License No.

Date

Signature of Licensee



# STATE WELL REPORT

## Part 2

**Pump Installer's Completion Report**  
 Mississippi Department of Environmental Quality  
 Office of Land and Water Resources  
 P.O. Box 2309  
 Jackson, MS 39225-2309  
 (601)961-5210  
 (601) 360-0535 (fax)

### For Office Use Only:

Well #: J24  
 Aquifer: \_\_\_\_\_

County: ~~Monroe~~ Itasca  
 Permit #: \_\_\_\_\_  
 Driller: Thomas Rossi #0509  
 Date completed: 02-11-2013  
Copy information from block on Part 1

*This part of the report must be completed by a licensed water well contractor or a licensed pump installer. A copy of Part 1 of the report must be attached and both parts filed with the Department at the above address within 30 days of well completion.*

Well Owner Information	Well Location
Owner Name: <u>Jonathan Black</u>	Latitude: <u>34°16'43.4604"</u> Longitude: <u>-88°15'4.918"</u>
Mailing Address: <u>448 Wilson Yielding Rd</u>	Method of Lat/Long (check one): Conventional Survey <u>XXXX</u> ,
<u>Fulton</u> MS <u>38843</u>	USGS quad _____, Hand-held GPS _____, Survey-grade GPS _____
City State Zip Code	<u>N</u> <u>1/4</u> <u>E</u> <u>1/4</u> , Sec <u>28</u> T <u>9</u> S R <u>10</u> E
Telephone No. <u>(662) 610-9134</u>	<u>7</u> Miles North of <u>Tremont</u> (Distance) (Direction) (Nearest Town)

**Pump Type (circle one)**

(Submersible) Turbine Air Lift Centrifugal Flowing Well Jet Piston Rotary Other (describe): \_\_\_\_\_

Date Pump Installed: 02-11-2013 Rated Pump Capacity: 10 Gallons Per Minute

Is This Pump (circle one): (New) Repaired Replacement

**Power Type (circle one)**

(Electric) Diesel Gasoline Natural Gas Tractor PTO Windmill Other (describe): \_\_\_\_\_

Horse Power Rating of Motor: one Setting Depth: 160 feet Number of Stages: \_\_\_\_\_

**Pump Test Data for Non Flowing Well**

Date Well Tested: \_\_\_\_\_ Duration of Pump Test (minimum 4 hours): 5 hours

Static Water Level (A): 135 Feet Below Land Surface Pumping Water Level (B) 160 Feet Below Land Surface

Drawdown [(B) - (A)]: \_\_\_\_\_ Feet Below Land Surface Test Pumping Rate: 10 Gallons Per Minute

Method of measurement (circle one): (Steel tape) Electric tape Air line Other (describe): \_\_\_\_\_

**Pump Test Data for Flowing Well**

Measured shut in head: \_\_\_\_\_ feet.

Well yielded \_\_\_\_\_ GPM with a drawdown of \_\_\_\_\_ feet after \_\_\_\_\_ hours of pumping

**Meter Installation**

Meter Manufacturer: \_\_\_\_\_ Meter Serial Number: \_\_\_\_\_

Meter Model Number/Name: \_\_\_\_\_ Type of Meter: \_\_\_\_\_

Totalizer Register Unit and Multiplier Factor (AF x .001, gal x 1000, etc): \_\_\_\_\_

Installation Date: \_\_\_\_\_ Meter installed by: \_\_\_\_\_

Is This Meter (circle one): New Repaired Replacement

**RECEIVED**  
MAY 20 2013  
BY: OLWR

*Important: By submitting the above information you are certifying that this meter was installed to manufacturer standards. For agricultural wells, a list of approved meters is on the MDEQ website.*

I HEREBY CERTIFY that the above statements are true to the best of my knowledge.

Thomas Rossi #0509 05-13-2013 Thomas Rossi

Print Name of Pump Installer and License No. (if applicable) Date Signature of Pump Installer


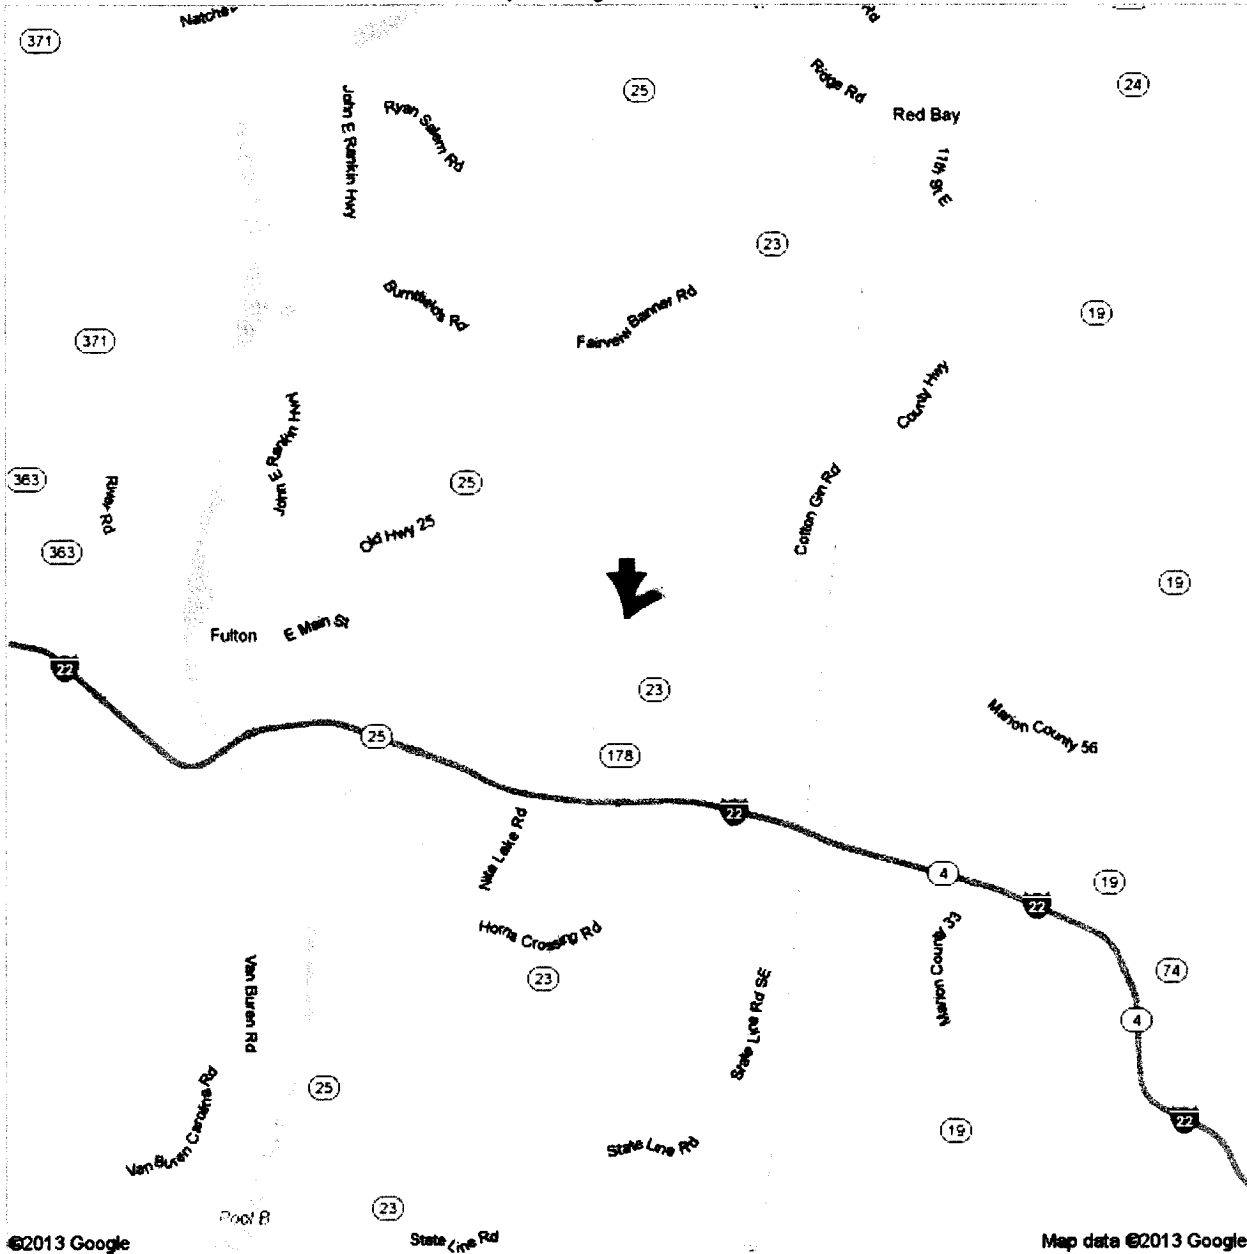
Jonathan Black  
448 Wilson Yielding Rd  
Fulton, MS  
Address Mississippi

J24

Google

34° 16' 43.4604"  
-88° 15' 4.918"

Get Google Maps on your phone  
Text the word "GMAPS" to 466453

©2013 Google

Map data ©2013 Google

RECEIVED  
MAY 20 2013  
BY: OLWR