

STATE WELL REPORT

Part 1

Driller's Log

Mississippi Department of Environmental Quality
Office of Land and Water Resources
P.O. Box 2309
Jackson, MS 39225-2309
(601)961-5210
(601)360-0535 (fax)

For Office Use Only:

Well #: 525
Aquifer: _____
E-Log #: _____

County: Itawamba
Permit #: _____
Driller: Ricky Holliday 5890
Date drilling completed: 8-14-13

State Law requires that this report be prepared by the license holder responsible for the work and filed with the Department at the above address within 30 days of completion of drilling of the well or borehole.

Well Owner Information <small>(Landowner if borehole is not for a water well)</small>	Well or Borehole Location
Owner Name: <u>Tommy Gholston</u>	Latitude: <u>34° 14' 59.95" N</u> Longitude: <u>88° 13' 10.81" W</u> <small>34-15-00 88-13-11</small>
Mailing Address: <u>L.M. Grady Road</u>	Method of Lat/Long (check one): Conventional Survey _____ USGS quad _____, Hand-held GPS <input checked="" type="checkbox"/> , Survey-grade GPS _____
Treatment <u>ms</u> 38876 City State Zip Code	<u>N 5 E 1/4 SW 1/4, Sec 2 35 T 10 S R 10 E</u> <small>MS</small>
Telephone No. <u>(662) 213-6934</u>	<u>4.1</u> Miles <u>NE</u> of <u>Treatment ms</u> (Distance) (Direction) (Nearest Town)

Well / Borehole Data
Date drilling started: <u>8-8-13</u> Date drilling completed: <u>8-14-13</u> Hole depth: <u>140</u> Hole diameter: <u>8"</u>
Location of the source of any surface water used for drilling: <u>Community System</u>
Method of dosing and volume of Chlorine used in drilling and development: _____
Logs run (circle all applicable): <input checked="" type="checkbox"/> No log run <input type="checkbox"/> Electric <input type="checkbox"/> Gamma Ray <input type="checkbox"/> Density <input type="checkbox"/> Sonic <input type="checkbox"/> Neutron <input type="checkbox"/> Other: _____
Name of organization running log(s): _____
Purpose of borehole (circle one): <input checked="" type="checkbox"/> Water Well <input type="checkbox"/> Geotechnical/Geological Investigation <input type="checkbox"/> Ground Source Heat Pump <input type="checkbox"/> Seismic Survey <input type="checkbox"/> Other (describe) _____
<i>If drilling is not related to water well construction, skip the remainder of this block</i>

Purpose of Well (circle all applicable): <input checked="" type="checkbox"/> Home <input type="checkbox"/> Industrial <input type="checkbox"/> Public Supply <input type="checkbox"/> Irrigation <input type="checkbox"/> Fish Culture
Other (describe): _____
If a flowing well, method of flow regulation: Valve _____ Other (describe) _____
Static Water Level: <u>114</u> feet [above or <input checked="" type="checkbox"/> below] and surface Date measured: <u>8-14-13</u> <small>(circle one)</small>
Method of measurement (circle one): <input checked="" type="checkbox"/> Steel tape <input type="checkbox"/> Electric tape <input type="checkbox"/> Air line <input type="checkbox"/> Other (describe): _____
Well depth: <u>140</u> Well grouted to a depth of: <u>10</u> feet Type of grout (circle one): <input checked="" type="checkbox"/> Neat Cement <input type="checkbox"/> Bentonite <input type="checkbox"/> Mix
Casing length: <u>130</u> feet Casing diameter: <u>4"</u> inches Type of casing: <u>PVC</u>
Screen length: <u>10'</u> feet Screen diameter: <u>48</u> inches Type of screen: <u>PVC</u>
Screen slot size: <u>010</u> inches Setting depth: From <u>130</u> feet to <u>140</u> feet
Type of completion (circle all applicable): <input checked="" type="checkbox"/> Gravel packed <input type="checkbox"/> Underreamed <input type="checkbox"/> Open hole <input type="checkbox"/> Natural Development
Other (describe): _____
Top of lap pipe or reduction in casing: _____ feet


If telescoped or more than one screen, describe on next page

County: Itawamba
 Permit #: _____

For Office Use Only:
 Well #: J25

The sketch below only required for water wells

If well telescopes, show depths on sketch.

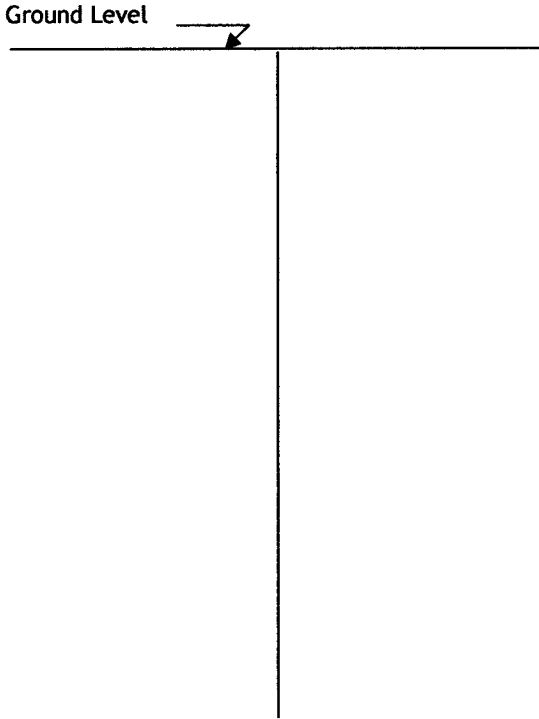

Description of formations encountered must be provided for all wells and boreholes, unless specifically exempted by regulations

Description of Formations Encountered	From (depth) Ground level	To (depth)
Clay	0	20
Clay	20	25
Rock	25	28
Clay/sand mix	28	40
Clay	40	60
Clay	60	65
Rock	65	70
Clay	70	74
Rock	74	77
Sand	77	80
Sand	80	86
Sand/gravel	86	100
Sand/gravel	100	120
Sand/gravel	120	140

If more than one screen, show location of each on sketch

Sketch the property layout and include the following:

- 1) the well location
- 2) any permanent structures on the property that may aid in locating the well
- 3) any roads, power lines, or other items that may aid in locating the property and the well
- 4) north arrow

RECEIVED

AUG 28 2013

BY: [Signature]

Landowner Name: _____

I HEREBY CERTIFY that the well/borehole was drilled, constructed, and completed in accordance with all applicable requirements of the Mississippi Department of Environmental Quality and the Mississippi Department of Health regulations, if applicable, and state laws.

Ricky Holliday 5890 8-21-13
 Print Name of Responsible Licensee and License No. Date

Ricky Holliday
 Signature of Licensee

STATE WELL REPORT

Part 2

Pump Installer's Completion Report

Mississippi Department of Environmental Quality
Office of Land and Water Resources
P.O. Box 2309
Jackson, MS 39225-2309
(601)961-5210
(601) 360-0535 (fax)

For Office Use Only:

Well #: 525
Aquifer: _____

County: Iowa
Permit #: _____
Driller: Ricky Holliday 5890
Date completed: 8-14-13
Copy information from block on Part 1

This part of the report must be completed by a licensed water well contractor or a licensed pump installer. A copy of Part 1 of the report must be attached and both parts filed with the Department at the above address within 30 days of well completion.

Well Owner Information	Well Location
Owner Name: <u>Tommy Galston</u>	Latitude: <u>34°14'59.95"</u> Longitude: <u>89°13'02.81"</u>
Mailing Address: <u>LM Grady Road</u>	Method of Lat/Long (check one): Conventional Survey _____, USGS quad _____, Hand-held GPS <input checked="" type="checkbox"/> , Survey-grade GPS _____
<u>Tremont</u> <u>MS</u> <u>38876</u>	<u>SE 1/4</u> <u>SW 1/4</u> , Sec <u>235</u> T <u>108</u> R <u>10 E</u>
City State Zip Code	<u>4.1</u> Miles <u>NE</u> of <u>Tremont MS</u>
Telephone No. <u>(662) 213-6934</u>	(Distance) (Direction) (Nearest Town)

Pump Type (circle one)

Submersible Turbine Air Lift Centrifugal Flowing Well Jet Piston Rotary Other (describe): _____

Date Pump Installed: 8-14-13 Rated Pump Capacity: 12 Gallons Per Minute

Is This Pump (circle one): New Repaired Replacement

Power Type (circle one)

Electric Diesel Gasoline Natural Gas Tractor PTO Windmill Other (describe): _____

Horse Power Rating of Motor: 1 Setting Depth: 137 feet Number of Stages: 18

Pump Test Data for Non Flowing Well

Date Well Tested: 8-14-13 Duration of Pump Test (minimum 4 hours): 6 1/2 hours

Static Water Level (A): 114 Feet Below Land Surface Pumping Water Level (B): 137 Feet Below Land Surface

Drawdown [(B) - (A)]: _____ Feet Below Land Surface Test Pumping Rate: 12 Gallons Per Minute

Method of measurement (circle one): Steel tape Electric tape Air line Other (describe): _____

Pump Test Data for Flowing Well

Measured shut in head: _____ feet.

Well yielded _____ GPM with a drawdown of _____ feet after _____ hours of pumping

Meter Installation

Meter Manufacturer: _____ Meter Serial Number: _____

Meter Model Number/Name: _____ Type of Meter: _____

Totalizer Register Unit and Multiplier Factor (AF x .001, gal x 1000, etc): _____

Installation Date: _____ Meter installed by: _____

Is This Meter (circle one): New Repaired Replacement

RECEIVED

Important: By submitting the above information you are certifying that this meter was installed to manufacturer standards. For agricultural wells, a list of approved meters is on the MDEQ website.

I HEREBY CERTIFY that the above statements are true to the best of my knowledge.


Ricky Holliday 5890 8-21-13 Ricky Holliday
Print Name of Pump Installer and License No. (if applicable) Date Signature of Pump Installer

J25

Google

Address Mississippi

Tommy Gholston
1438 LM Grady Rd.
Tremont, MS

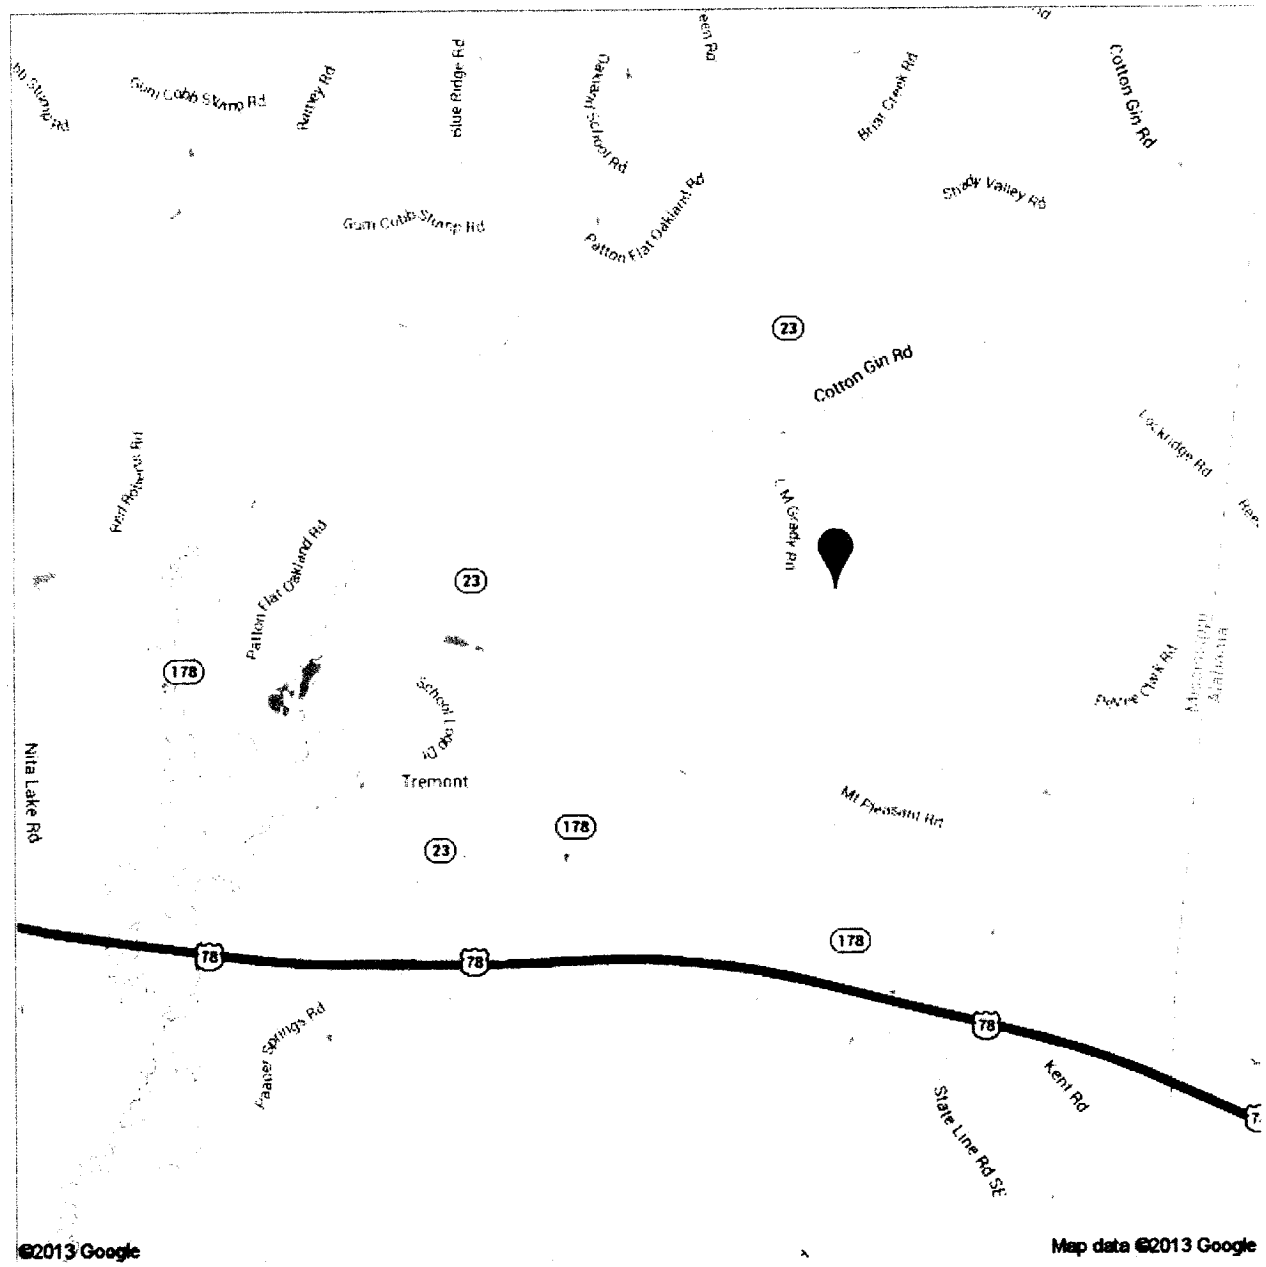

RECEIVED
AUG 26 2013
BY: OLWR