

STATE WELL REPORT

Part 1

Driller's Log

Mississippi Department of Environmental Quality
Office of Land and Water Resources
P.O. Box 2309
Jackson, MS 39225-2309
(601)961-5210
(601)360-0535 (fax)

For Office Use Only:

Well #: J 26
Aquifer: _____
E-Log #: _____

County: Itawamba
Permit #: _____
Driller: Ricky Holliday
Date drilling completed: 9-19-13

State Law requires that this report be prepared by the license holder responsible for the work and filed with the Department at the above address within 30 days of completion of drilling of the well or borehole.


Well Owner Information <small>(Landowner if borehole is not for a water well)</small>	Well or Borehole Location
Owner Name: <u>Tim Dill</u>	Latitude: <u>N 24° 17' 46.5"</u> Longitude: <u>W 89° 23' 27"</u>
Mailing Address: <u>1140 Briar Creek Road</u>	Method of Lat/Long (check one): Conventional Survey _____
<u>Tremont</u> MS <u>38876</u>	USGS quad _____, Hand-held GPS <input checked="" type="checkbox"/> , Survey-grade GPS _____
City State Zip Code	<u>S 1/4</u> <u>W 1/4</u> , Sec <u>13</u> T <u>9S</u> R <u>10E</u>
Telephone No. (662) <u>491-1082</u>	<u>6</u> Miles <u>NE</u> of <u>Tremont</u>
	(Distance) (Direction) (Nearest Town)

Well / Borehole Data
Date drilling started: <u>9-16-13</u> Date drilling completed: <u>9-19-13</u> Hole depth: <u>77</u> Hole diameter: <u>8"</u>
Location of the source of any surface water used for drilling: <u>community water system</u>
Method of dosing and volume of Chlorine used in drilling and development: _____
Logs run (circle all applicable): <u>No log run</u> Electric Gamma Ray Density Sonic Neutron Other: _____
Name of organization running log(s): _____
Purpose of borehole (circle one): <u>Water Well</u> Geotechnical/Geological Investigation Ground Source Heat Pump Seismic Survey Other (describe) _____
<i>If drilling is not related to water well construction, skip the remainder of this block</i>
Purpose of Well (circle all applicable): <u>Home</u> Industrial Public Supply Irrigation Fish Culture
Other (describe): _____
If a flowing well, method of flow regulation: Valve _____ Other (describe) _____
Static Water Level: <u>47</u> feet [above or <u>below</u> land surface (circle one) Date measured: _____
Method of measurement (circle one): <u>Steel tape</u> Electric tape Air line Other (describe): _____
Well depth: <u>77</u> Well grouted to a depth of: <u>12</u> feet Type of grout (circle one): <u>Neat Cement</u> Bentonite Mix
Casing length: <u>67</u> feet Casing diameter: <u>4"</u> inches Type of casing: <u>PVC</u>
Screen length: <u>10</u> feet Screen diameter: <u>4"</u> inches Type of screen: <u>PVC</u>
Screen slot size: <u>0.10</u> inches Setting depth: From <u>67</u> feet to <u>77</u> feet
Type of completion (circle all applicable): <u>Gravel packed</u> Underreamed Open hole Natural Development
Other (describe): _____
Top of lap pipe or reduction in casing: _____ feet
<i>If telescoped or more than one screen, describe on next page</i>

County: Itawamba
 Permit #: 5890

For Office Use Only:
 Well #: 126

The sketch below only required for water wells
If well telescopes, show depths on sketch.

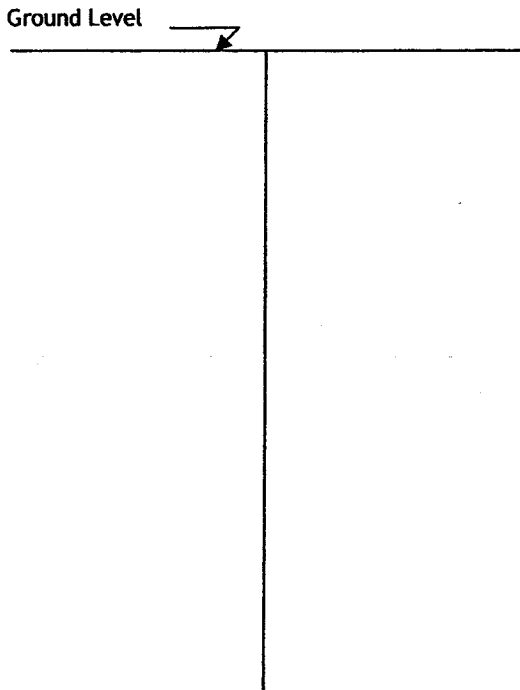

Description of formations encountered must be provided for all wells and boreholes, unless specifically exempted by regulations

Description of Formations Encountered	From (depth)	To (depth)
	Ground level	
Clay Clay	0	14
Rock	14	16
Clay + gravel	16	20
Rock	20	26
Clay	26	30
Sand + clay	30	35
Sand + clay + Rock	35	40
Sand + clay + Rock + shells	40	45
Sand + gravel	45	60
Sand + gravel	60	77

If more than one screen, show location of each on sketch

- Sketch the property layout and include the following:
- 1) the well location
 - 2) any permanent structures on the property that may aid in locating the well
 - 3) any roads, power lines, or other items that may aid in locating the property and the well
 - 4) north arrow

Landowner Name: _____

I HEREBY CERTIFY that the well/borehole was drilled, constructed, and completed in accordance with all applicable requirements of the Mississippi Department of Environmental Quality and the Mississippi Department of Health regulations, if applicable, and state laws.

Ricky Holiday 5890 9-20-13 Ricky Holiday
 Print Name of Responsible Licensee and License No. Date Signature of Licensee

STATE WELL REPORT

Part 2

Pump Installer's Completion Report
 Mississippi Department of Environmental Quality
 Office of Land and Water Resources
 P.O. Box 2309
 Jackson, MS 39225-2309
 (601)961-5210
 (601) 360-0535 (fax)

County: ITAWAPA
 Permit #: _____
 Driller: Ricky Holliday 5590
 Date completed: 9-19-13
Copy information from block on Part 1

For Office Use Only:

Well #: 526
 Aquifer: _____

This part of the report must be completed by a licensed water well contractor or a licensed pump installer. A copy of Part 1 of the report must be attached and both parts filed with the Department at the above address within 30 days of well completion.

Well Owner Information	Well Location
Owner Name: <u>Tim Dill</u>	Latitude: <u>N 34° 17' 46.6"</u> Longitude: <u>W 88° 12' 33.9"</u>
Mailing Address: <u>1140 Briar Creek Road</u>	Method of Lat/Long (check one): Conventional Survey _____, USGS quad _____, Hand-held GPS <input checked="" type="checkbox"/> , Survey-grade GPS _____
Treatment <u>ms</u> City <u>Treatment</u> State <u>ms</u> Zip Code <u>38876</u>	<u>5 1/4</u> Miles <u>W</u> of <u>Treatment</u> (Distance) (Direction) (Nearest Town)
Telephone No. (662) <u>491-1082</u>	

Pump Type (circle one)

Submersible Turbine Air Lift Centrifugal Flowing Well Jet Piston Rotary Other (describe): _____

Date Pump Installed: 9-18-13 Rated Pump Capacity: 12 Gallons Per Minute

Is This Pump (circle one): New Repaired Replacement

Power Type (circle one)

Electric Diesel Gasoline Natural Gas Tractor PTO Windmill Other (describe): _____

Horse Power Rating of Motor: 1/2 Setting Depth: 74 feet Number of Stages: 14

Pump Test Data for Non Flowing Well

Date Well Tested: 9-18-13 Duration of Pump Test (minimum 4 hours): 16 hours

Static Water Level (A): 47 Feet Below Land Surface Pumping Water Level (B): 74 Feet Below Land Surface

Drawdown [(B) - (A)]: 52 Feet Below Land Surface Test Pumping Rate: 12 Gallons Per Minute

Method of measurement (circle one): Steel tape Electric tape Air line Other (describe): _____

Pump Test Data for Flowing Well

Measured shut in head: _____ feet.

Well yielded 12 GPM with a drawdown of 5 feet after 16 hours of pumping

Meter Installation

Meter Manufacturer: _____ Meter Serial Number: _____

Meter Model Number/Name: _____ Type of Meter: _____

Totalizer Register Unit and Multiplier Factor (AF x .001, gal x 1000, etc): _____

Installation Date: _____ Meter installed by: _____

Is This Meter (circle one): New Repaired Replacement

Important: By submitting the above information you are certifying that this meter was installed to manufacturer standards. For agricultural wells, a list of approved meters is on the MDEQ website.

I HEREBY CERTIFY that the above statements are true to the best of my knowledge.

Ricky Holliday 5590 9-20-13 Ricky Holliday
 Print Name of Pump Installer and License No. (if applicable) Date Signature of Pump Installer

J26



Maps | Country - State | Places | Google Earth | Cities | Earthquakes | Lat - Long

Home » Latitude and Longitude of a Point

To find the latitude and longitude of a point **Click** on the map, **Drag** the marker, or enter the...

Address: 1140 Briar Creek Road Tremont, Ms 38876 [Go](#)

Map Center: [Get Address](#) - [Land Plat Size](#) - [Street View](#) - [Rectangle Tool](#) - [Area Photographs](#)


Try out [3D Google Earth](#). Google Earth gives you a 3D look of the area around the center of the map, which is usually your last click point, and includes latitude, longitude and elevation information.

Catalent Challenge Us

Reduce Clinical Timelines with Integrated Solutions

[Pharmaceuticals](#) [Medical Devices](#) [Medical Manufacturing](#)
[Medical Supply](#) [Medical Packaging](#) [Medical Device Assembly & Blending](#) [Medical Device Supply Chain Management](#)


Everything you love, now on your TV. For \$35.



chromecast

Buy Now

Latitude and Longitude of a Point

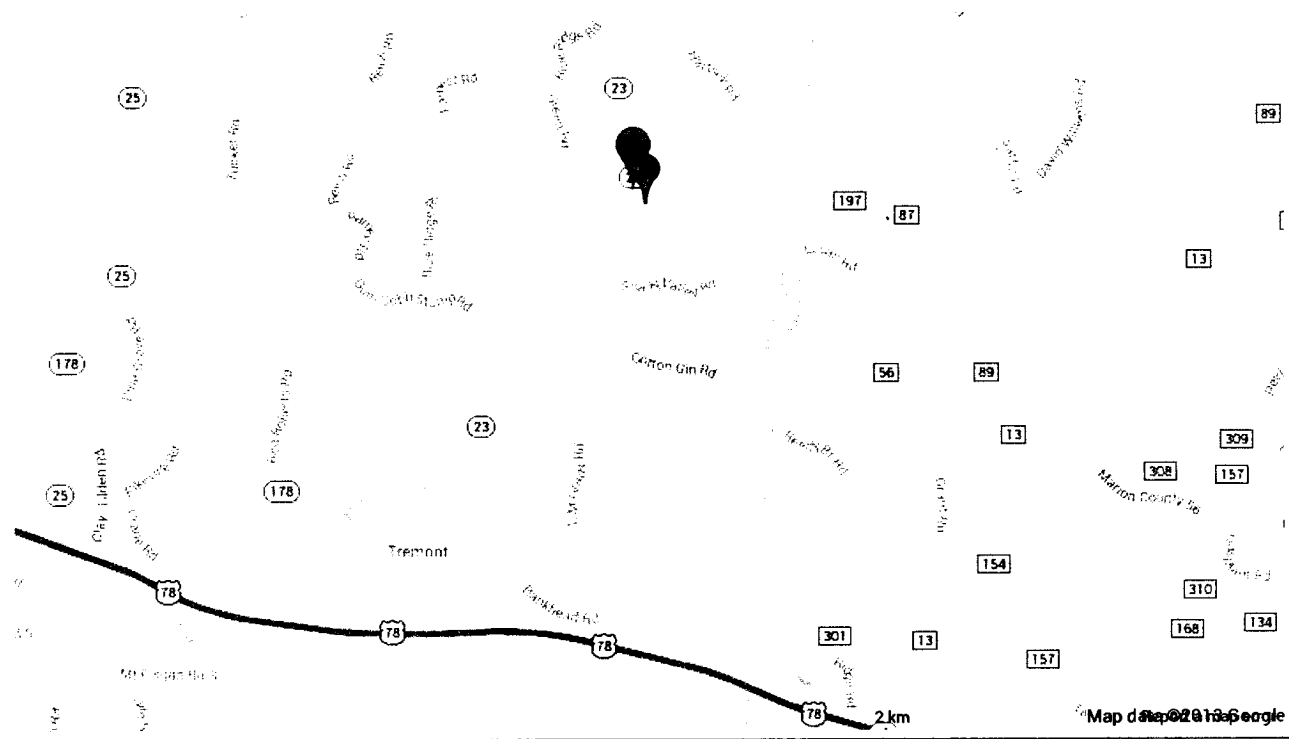

<p>Clear / Reset Remove Last Blue Marker Center Red Marker</p> <hr/> <p>Get the Latitude and Longitude of a Point</p> <p>When you click on the map, move the marker or enter an address the latitude and longitude coordinates of the point are inserted in the boxes below.</p> <p>Latitude: 34.296278</p>	<p>Show Point from Latitude and Longitude</p> <p>Use this if you know the latitude and longitude coordinates of a point and want to see where on the map the point is. Use: + for N Lat or E Long - for S Lat or W Long. Example: +40.689060 -74.044636 Note: Your entry should not have any embedded spaces.</p> <p>Decimal Deg. Latitude: Decimal Deg. Longitude:</p>
--	--

RECEIVED
SEP 26 2013
BY OLIVER