	STATE	WELL REPORT	480	
County:	Part 1 Driller's Log Mississippi Department of Environmental Quality Office of Land and Water Resources P.O. Box 2309 Jackson, MS 39225-2309		For Office Use Only: Well #:J_3C	
Permit #: Robert Gentry Driller:8/24/18			Aquifer:	
Date drilling completed:	-	601)961-5555 1)961-5228 (fax)		
State Law requires that this report Department at the above address	t be prepared by the	license holder responsible for t	he work and filed with the or borehole.	
Well Owner Information		Well or Bore	hole Location	
(Landowner if borehole is not for Owner Name: Michael Brown	r a water well)	Latitude: <u>N 34°18' 02.93"</u> Longitude: <u>W 088° 10' 39.08"</u>		
		Method of Lat/Long (check one): Conventional Survey,	
Mailing Address: 869 Miss Ala Rd		USGS guad, Hand-held G	PS <u>X</u> , Survey-grade GPS	
	38876		18 T 95 RILE	
Tremont MS City State	Zip Code			
Telephone No. (<u>662</u>) 231-9189		(Distance) (Direction)	f(Nearest Town)	
			DECEIVE	
<i>If drilling is not re</i> Purpose of Well (check all applicable):	ine used in drilling a run Electric Gam na r Well Geotechn nic Survey Other <i>lated to water well c</i>	and development: ma Ray Density Sonic Neutro ical/Geological Investigation (describe) construction, skip the remainded	BY OL . on Other: NA Ground Source Heat Pump r of this block	
Other (<i>describe</i>): If a flowing well, method of flow regu		Other (describe)		
Static Water Level:feet above or below] land surface Date measured:feet (check one)				
Method of measurement (check one) Well depth: <u>119</u> Well grouted to Casing length: <u>120</u> feet Screen length: <u>20</u> feet Screen slot size: <u>0.020</u> inche	a depth of: <u>10</u> Casing diameter: <u>6</u> - Screen diameter: <u>2</u> s Setting depth	feet Type of grout (check one) 5/8"inches Type of inches Type of irches Type of feet t	□Neat Cement Bentonite Mix casing:	
Other (describe):				
Top of lap pipe or reduction in casing				
If teles	coped or more than	one screen, describe on next po	nge	

_1. . v

Form: OLWR-SWR-1A (4/13)

County:	
Permit #:	

K

Ground Level


For Office Use Only:				
Well #:	J30			

The sketch below only required for water wells

Description of formations encountered must be provided for all wells and boreholes, unless specifically exempted by regulations If well telescopes, show depths on sketch.

Description of Formations Encountered	From (depth)	To (depth)	
	Ground level		
Red Clay	0	20	
Sand, Clay, Gravel	20	69	
Gravel	69	89	
Gray Clay	89	99	
Heaving Sand	99	119	
	-		
		-05	IVED 4 2018 LWR
		RECE	IV L=
		DEC A	4 2018
		DECO	
			IWR
		BYU	
		I	ļ

If more than one screen, show location of each on sketch

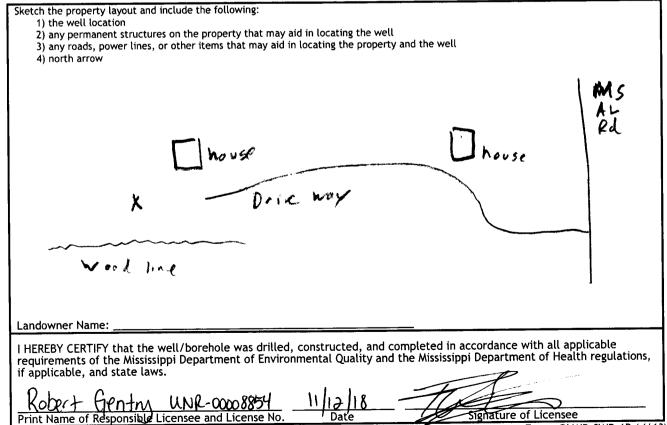

STATE WELL REPORT					
County: Itawamba]	Part 2	For Office Use Only:		
Permit #: NA		er's Completion Report	Well #:3C		
Driller: Robert Gentry		nent of Environmental Quality nd and Water Resources	well #:		
Date completed:9/04/18		2.0. Box 2309	Aquifer:		
Copy information from block on Part 1		on, MS 39225-2309 601)961-5210			
	L (601) 360-0535 (fax)			
This part of the report must be completed by a licensed water well contractor or a licensed pump installer. A copy of Part 1 of the report must be attached and both parts filed with the Department at the above address within 30 days of well completion.					
Well Owner Information Well Location					
Owner Name: Michael Brown		Latitude: <u>N 34°18' 02.93"</u> Longitude: <u>W 088° 10' 39.08"</u>			
Mailing Address:		Method of Lat/Long (check one)): Conventional Survey,		
869 Miss Ala Rd		USGS quad, Hand-held GI	PS <mark>X</mark> , Survey-grade GPS		
Tremont MS	38876	SE 14 NE 14. Sec	18 T 95 R 11E		
City State	Zip Code				
Telephone No. ()		Miles of (Distance) (Direction)	(Nearest Town)		
	Pump Ty	pe (check one)			
Submersible 🗹 Turbine 🗌 Air Lift 🔲 Centri	fugal 🗍 Flowing Well	Jet Piston Rotary Other (de	scribe):		
Date Pump Installed: <u>9/4/18</u> Is This Pump (check one): New Re		Bated Rump Capacity: 10	Gallons Per Minute		
Is This Pump (check one): <mark>] New</mark> Re	paired Replaceme	nt r pe (c heck <i>one</i>)	RECLE		
Electric ☑ Diesel ☐ Gasoline □ Natural Ga		PC (0.00000 0000)			
Horse Power Rating of Motor: <u>3/4</u>	Setting Dep	th:feet Number	of stages:		
	•	for Non Flowing Well	Ľ		
Date Well Tested: <u>8/24/18</u>		Duration of Pump Test (minim	num 4 hours): hours		
Static Water Level (A): Fee	et Below Land Surface	Pumping Water Level (B): _	Feet Below Land Surface		
Drawdown [(B) - (A)]:	_Feet Below Land Sur		Gallons Per Minute		
Method of measurement (check one): S	Steel tape Electric t	ape 🛛 Air line 🗹 Other (describe):	Tested by blowing w/ rig		
Method of measurement (eneck one).	Pump Test Da	ita for Flowing Well			
Measured shut in head:fee	t.				
		feet after	hours of pumping		
Well yieldedGPM with a drawdown offeet afterhours of pumping					
Meter Installation					
	Meter Serial Number:				
Meter Model Number/Name: Type of Meter:					
Totalizer Register Unit and Multiplier Factor (AF x .001, gal x 1000, etc):					
Installation Date: Meter installed by:					
Is This Meter (check one): New Repaired Replacement					
Important: By submitting the above information you are certifying that this meter was installed to manufacturer standards. For agricultural wells, a list of approved meters is on the MDEQ website.					
I HEREBY CERTIFY that the above statements are true to the best of my knowledge.					
Robert Greating 11118 among 154					
Print Name of Pump Installer and License No. (<i>if applicable</i>) Date Signature of Pump Installer					

e. \$ ت . •

Form: OLWR-SWR-2A (4/13)