

ITAWAMBA

MISSISSIPPI BOARD OF WATER COMMISSIONERS

CODED

WATER WELL DRILLERS LOG

CODED

8-23-62

Date: Aug 23, 1962, Driller: HERNDON WELL & SUPPLY CO.
P. O. BOX 48 County Itawamba
MIANNON, MISSISSIPPI

	Description & Color of Materials Sand, Clay, Red Clay, Shell, etc.	Thick- ness Feet	Depth Feet
(1) Owner of Land: <u>Dorsey School</u> (Name)			0
<u>Dorsey, Mississippi</u> (Address)	<u>surface sand & clay</u>		
(2) Location: <u>NW 1/4, NW 1/4, Sec 10, T. 8N, R. 9E</u> <u>105</u> — miles — of <u>Dorsey</u> (distance) (direction) (Nearest Town)	<u>Other work</u>		35
(3) Topography: <u>Hilly</u> (Hilly) (Flat) (Level)	<u>Sand</u>		90
(4) Purpose of Well: <u>School</u> (Domestic Irrigation Municipal, Industrial, Other)	<u>Bottom</u>		180

Information upon completion of well:


- (1) Diameter 6 inches.
- (2) Total Depth 180 feet.
- (3) Water Level 98 feet below top of ground.
- (4) Cased to 127', Size 6"
- (5) Screen: Size 2 1/2", Length 20'
- (6) Were any formations sealed against pollution?
 yes, no.

CODED

If YES depth of formation 35'

Why Surface & sand

Drillers Remarks:

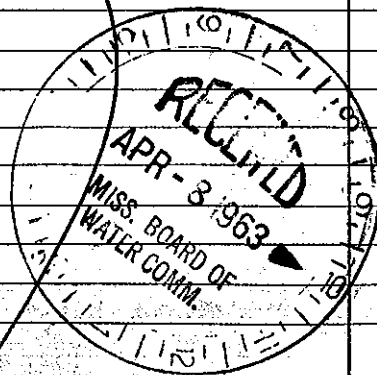

(Use Back Side)

Well No.

76

Mail this copy to Board of Water Commissioners 429 Miss. St. Jackson, Miss.