

ITAWAMBA MISSISSIPPI BOARD OF WATER COMMISSIONERS

K22
5-24-61

CODED

WATER WELL DRILLERS LOG
HERNDON WELL & SUPPLY CO.

CODED

P. O. BOX 42

Date: Mar 24, 1961, Driller: SHANNON, MISSISSIPPI County: ITAWAMBA
74 (Name)

(1) Owner of Land: <u>Clyde Walton</u> (Name)	Description & Color of Materials Sand, Clay, Red Clay, Shell, etc.	Thick- ness Feet	Depth Feet
<u>Plot 1 Tupelo, Miss</u> <u>N¹/₂ NESE</u> (Address)	<u>Surface sand</u>		<u>0</u>
(2) Location: <u>1/4, 1/4, Sec. 2 T. 10 S. R. 7 E</u> <u>1/4</u> miles <u>—</u> of <u>Baldwin</u> (distance) (direction) (Nearest Town)	<u>clay</u> <u>Blue rock</u>		<u>45</u>
(3) Topography: <u>Flat</u> (Hilly) (Flat) (Level)	<u>Sand</u>		<u>60</u>
(4) Purpose of Well: <u>Home use</u> (Domestic Irrigation Municipal, Industrial, Other)	<u>Bottom</u>		<u>140</u>

Information upon completion of well:

- (1) Diameter 4 inches.
- (2) Total Depth 140 feet.
- (3) Water Level 50 feet below top of ground.
- (4) Cased to 51', Size 4".
- (5) Screens: Size —, Length —.
- (6) Were any formations sealed against pollution?
yes, no.


If YES depth of formation 45'

Why Surface & Sand

Drillers Remarks:

221

CODED

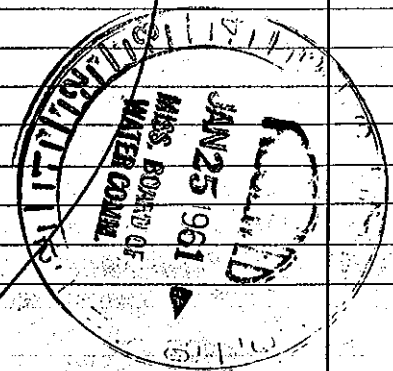

(Use Back Side)

Well No.