

ITAWAMBA MISSISSIPPI BOARD OF WATER COMMISSIONERS

K25

CODED

CODED

6-17-63

WATER WELL DRILLERS LOG

Date: 6-17, 1963, Driller: ERNDON WELL & SUPPLY CO. County: Itawamba

4

P. O. BOX 42
STANNON, MISSISSIPPI

(1) Owner of Land: <u>Gene Mills</u> (Name)	Description & Color of Materials Sand, Clay, Red Clay, Shell, etc.	Thick- ness Feet	Depth Feet
<u>Darryl Miss</u> (Address)	<u>surface sand</u> <u>+ clay</u>		0
(2) Location: <u>SE 1/4, SE 1/4, Sec 12 T 10 S R 7 E</u> of <u>Greenwood</u> (Nearest Town)	<u>Blue mud</u> <u>&</u> <u>sand</u>		20 90
(3) Topography: <u>Flat</u> (Hilly) (Flat) (Level)	<u>Bottom</u>		
(4) Purpose of Well: <u>Domestic</u> (Domestic Irrigation Municipal, Industrial, Other)			113

Information upon completion of well:

(1) Diameter 4 inches.

(2) Total Depth 113 feet.

(3) Water Level 40 feet below top of ground.

(4) Cased to 108', Size 4" Plastic

(5) Screen: Size 4", Length 5'

(6) Were any formations sealed against pollution?

yes, no.


If YES depth of formation 20'

Why surface & sand

Drillers Remarks: plastic

case & screen

CODED

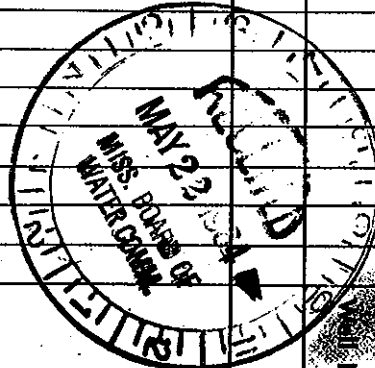

(Use Back Side)

Mail this copy to Board of Water Commissioners: 429 Miss. St. Jackson, Miss.