

Stewart  
K28  
7-64

MISSISSIPPI BOARD OF WATER COMMISSIONERS

CODED  
CODED  
CODED

WATER WELL DRILLERS LOG

Date: 7/7, 1966, Driller: W. W. [unclear] County: [unclear]  
(Name)

(1) Owner of Land: James Mills  
(Name) MILLS  
Dorsey Rt. 2  
(Address)  
(2) Location: SE 1/4, NW 1/4, Sec. 11, T10R8  
5 miles SE of Dorsey  
(distance) (direction) (Nearest Town)  
(3) Topography: Hilly  
(Hilly) (Flat) (Level)  
(4) Purpose of Well: Domestic  
(Domestic Irrigation  
Municipal, Industrial, Other)


| Description & Color of Materials<br>Sand, Clay, Red Clay, Shell, etc. | Thick-<br>ness<br>Feet | Depth<br>Feet |
|---|------------------------|---------------|
| Joint Clay  | 0                      | 30            |
| Blue  | 30                     | 100           |
| Sand  | 100                    | 152           |

Information upon completion of well:

(1) Diameter 4 inches.  
(2) Total Depth 152 feet.  
(3) Water Level 32 feet below top of ground.  
(4) Cased to 62 ft. Size 4 in.  
(5) Screen: Size \_\_\_\_\_, Length \_\_\_\_\_  
(6) Were any formations sealed against pollution?  
\_\_\_\_\_ yes, \_\_\_\_\_ no.

CODED

If YES depth of formation \_\_\_\_\_  
Why \_\_\_\_\_  
Drillers Remarks: \_\_\_\_\_

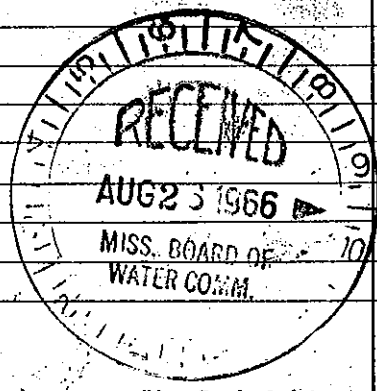

Well No.

(Use Back Side)

Mail this copy to Board of Water Commissioners 429 Miss. St. Jackson, Miss.