

Stawamba  
K29  
8-66

MISSISSIPPI BOARD OF WATER COMMISSIONERS

WATER WELL DRILLERS LOG

CODED

CODED

Date: 8/11, 1966, Driller: G. Wing Saco, County: Lee  
(Name)


(1) Owner of Land: MARVIN Gillette  
(Name)  
Dorsey (Address)  
(2) Location: NE 1/4, SW 1/4, Sec. 11, T19S, R8E  
4 miles SE, of Dorsey  
(distance) (direction) (Nearest Town)  
(3) Topography: Hilly  
(Hilly) (Flat) (Level)  
(4) Purpose of Well: Domestic  
(Domestic Irrigation, Municipal, Industrial, Other)

Description & Color of Materials Sand, Clay, Red Clay, Shell, etc.	Thick- ness Feet	Depth Feet
Blue clay	0	30
Blue clay	30	50
Sand	50	93

CODED

Information upon completion of well:

(1) Diameter 4 inches.  
(2) Total Depth 93 feet.  
(3) Water Level 30 feet below top of ground.  
(4) Cased to 93 ft, Size fine  
(5) Screen: Size \_\_\_\_\_, Length \_\_\_\_\_  
(6) Were any formations sealed against pollution?  
\_\_\_\_\_ yes, \_\_\_\_\_ no.  
If YES depth of formation \_\_\_\_\_  
Why \_\_\_\_\_  
Drillers Remarks: \_\_\_\_\_

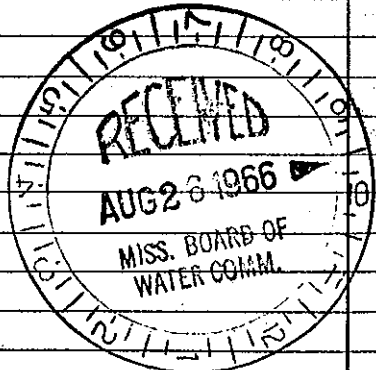

Well No.

(Use Back Side)

Mail this copy to Board of Water Commissioners 429 Miss. St. Jackson, Miss.