

*Hawamba*  
**K31**  
8-66

MISSISSIPPI BOARD OF WATER COMMISSIONERS

WATER WELL DRILLERS LOG

**CODED**

**CODED**

**CODED**

Date: 8/12, 1966, Driller: G. W. King Gas Co. County: Hawamba  
(Name)

862 3761

(1) Owner of Land: GASTON Moore  
(Name)

Dorsey St. 21  
(Address)

(2) Location: SE 5 E 1/4, Sec. 11, T. 103, R. 2

5 miles SE of Dorsey  
(distance) (direction) (Nearest Town)

(3) Topography: hilly  
(Hilly) (Flat) (Level)

(4) Purpose of Well: Domestic  
(Domestic Irrigation Municipal, Industrial, Other)

Description & Color of Materials Sand, Clay, Red Clay, Shell, etc.	Thick- ness Feet	Depth Feet
<u>joint clay</u>	<u>0</u>	<u>30</u>
<u>blue clay</u>	<u>30</u>	<u>50</u>
<u>sand</u>	<u>50</u>	<u>82</u>

Information upon completion of well:

(1) Diameter 4 inches.

(2) Total Depth 82 feet.

(3) Water Level 32 feet below top of ground.

(4) Cased to 37 ft, Size 4 in.

(5) Screen: Size \_\_\_\_\_, Length \_\_\_\_\_.

(6) Were any formations sealed against pollution?  
\_\_\_\_\_ yes, \_\_\_\_\_ no.

If YES depth of formation \_\_\_\_\_

Why \_\_\_\_\_


Drillers Remarks: \_\_\_\_\_

**CODED**

**CODED**

**CODED**

**CODED**

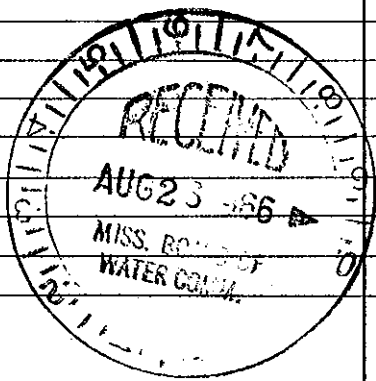

Well No.

(Use Back Side)

Mail this copy to Board of Water Commissioners 429 Miss. St. Jackson, Miss.