

ITAWAMBA MISSISSIPPI BOARD OF WATER COMMISSIONERS

L7
10-65

CODED

WATER WELL DRILLERS LOG

CODED

Date: October, 1965, Driller: Johnny Webb County Itawamba
 4 2nd no. on file (Name)

	Description & Color of Materials Sand, Clay, Red Clay, Shell, etc.	Thick- ness Feet	Depth Feet
(1) Owner of Land: <u>Zommy Wiggul</u> (Name)	<u>Clay 8 15'</u>		
<u>Zildes, Mississippi</u> (Address)	<u>Sand & Clay 15-50'</u>		
(2) Location: <u>NE 1/4, SE 1/4, Sec. 27 T10R9</u> <u>SE</u>	<u>Sand & gravel 50-150'</u>		
<u>5</u> miles <u>S-E</u> , of <u>Fulton</u> (distance) (direction) (Nearest Town)	<u>Gravel 150-190'</u>		
(3) Topography: <u>1</u> (Hilly) (Flat) (Level)			
(4) Purpose of Well: <u>Domestic</u> (Domestic Irrigation Municipal, Industrial, Other)			

CODED

Information upon completion of well:

(1) Diameter 4 inches.

(2) Total Depth 195' feet.

(3) Water Level 100' feet below top of ground.

(4) Cased to 185', Size 4"

(5) Screen: Size 4", Length 10'


(6) Were any formations sealed against pollution?
 _____ yes, _____ no.

If YES depth of formation _____

Why _____

Drillers Remarks: New Brick house
Well at Chickasaw house

I 24

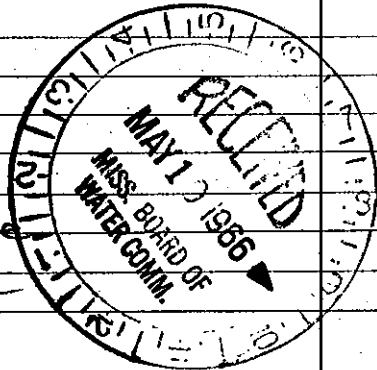

Well No.

(Use Back Side)