

I-tawamba
L 10
9-66

MISSISSIPPI BOARD OF WATER COMMISSIONERS

WATER WELL DRILLERS LOG

CODED

CODED

Date: 9-22, 1966, Driller: J. C. REEVES County: ITTAWAMBA
(When well drilled) (Name) (Where well is located)

(1) Owner of Land:	Description & Color of Materials Sand, Clay, Red Clay, Shell, etc.	Thick- ness Feet	Depth Feet
<u>KENNETH JOHNSON</u> (Name) <u>TILDEN</u> 8624975 (Address)	<u>RED CLAY</u>	<u>23</u>	<u>0</u>
<u>NE SW</u> (Address) <u>2 10 9</u>	<u>RED SAND</u>	<u>83</u>	<u>23</u>
(2) Location: <u>NE SW</u> , <u>2 10 9</u> , Sec. <u>2 10 9</u>			
<u>8</u> miles <u>SE</u> of <u>FULTON</u> (distance) (direction) (Nearest Town)			
(3) Topography: <u>HILLY</u> (Hilly) (Flat) (Level)			
(4) Purpose of Well: <u>CHICKENS</u> (Domestic Irrigation Municipal, Industrial, Other)			

CODED

Information upon completion of well:

- (1) Diameter 4 inches.
- (2) Total Depth 106 feet.
- (3) Water Level 58 feet below top of ground.
- (4) Cased to 86', Size 4" PVC.
- (5) Screen: Size 4", Length 20'.
- (6) Were any formations sealed against pollution?
_____ yes, _____ no.

If YES depth of formation _____


Why _____

Drillers Remarks: _____

Yield in gpm: 10

Size pump: 1/2 HP. SUB

Type power: ELECT

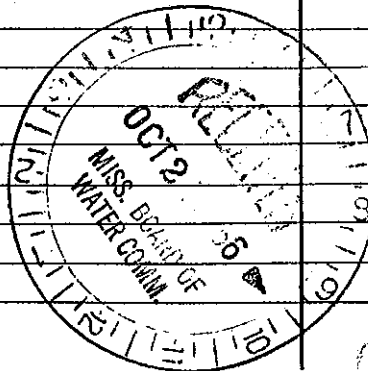

Mail this copy to Board of Water Commissioners 429 Miss. St. Jackson, Miss.