State Wen Report				
County: I + A W A m b A Part 1	For Office Use Only:			
Mississippi Department of Environmental Quality	Aquifer:			
Office of Land and Water Resources				
Driller Kosse Drillenc PO Rox 10631	Well #:			
Jackson, MS 39289-0631	I C D			
1 1 1 1 1 1 1 1 1 1 1 1 1 1 1 1 1 1 1 1	L. S. Elevation:			
(601)354-6938 (fax)	B-log #:			
State Law requires that this second by				
State Law requires that this report be prepared by the driller in detail and filed wi  30 days of completion of drilling of the well.	th the Department within			
Well Corner Laboration				
	Location			
Owner Name KICK MOORE Latitude: 34 • 11 • 42 •				
Mailing Address: 4433 WhITE SKRINGS RU Method of Lattle one (circle one	roughings: 33 . XC . XI			
Mailing Address: 4933 While Skring S NO Method of Lat/Long (circle one	): Conventional Survey			
	-			
USGS quad, Hand-held C	JPS, Survey-grade GPS			
City Nate Zip Code SN4 SE 14 Sec ZZ	m 105 - 07			
City State Zip Code	IWn / Rng 7 E			
Telephone No. (6/2) 1/3 - 7/, 99 Distance Direction	Nearest Town			
Miles of	f			
Well Data				
Purpose of Well (circle one) Home Industrial Public Supply Irrigation Fish Culture				
Date mail deliting areas a Color of Col	Other:			
Date well drilling started: 8/19/09 Date well drilling completed: 8/	2//89			
If flowing, method of flow regulation: Valve Other (describe)				
Other (describe)				
Static Water Level: _/ 70feet above or below (circle one) land surface Date measured:	7 2 1 7 6			
Method of Management (-)	8-21-09			
Method of Measurement (circle one) seed tape electric tape air line other:				
Hole depth: 300 Well depth: 300 FT				
Hole depth: 300 FT Well grouted to a depth offeet				
A special ground (circle one): Cement Bentomite Mix				
INTER TWO ACTIONS	PV <			
1 ACTION tonother 7 (/ c				
screen diameterinches Type of screen:				
Screen slot size: C, /3 inches Setting depth: From Bottom feet to 270 feet				
Type of completion (circle all and	foot			
Type of completion (circle all applicable): Gravel packed Underreamed Telescoped Open hok	Natural Desertan			
	Natural Development			
Other (describe):				
Top of lap pipe or reduction in casing:				
The state of the s	describe on back of page			
Logs run (carcie all applicable): No log run Electric Gamera Para Danata C				
Name of organization annuity to the				
I certify that the well was drilled, constructed, and completed in accordance with all applicable requirement of Environmental Quality and/or the Ministrative Department of Environmental Quality and/or the Ministrative Department.	1			
Denoriment of Registeres and Completed in accordance with all applicable requ	irements of the Mississippl			
Department of Environmental Quality and/or the Mississippi Department of Health regulations and state laws.				
	Secret MAS.			
160mas 10551 0-509 7	$\overline{\mathcal{C}}$			
Print Name of Water Well Contractor and License No.	1)adda			
Signature of Water	Well Contractor			

				•		
The sketch	below	ontv	reautred	tor	water	wals


# If well telescopes, show depths on sketch.

Ground Level.

### Description of formations encountered must be provided for all wells and boreholes, unless specifically exempted by regulations

Description of Formations Encountered	From (depth)	To (depth)
	Ground Level	
e la V	0	80
clay Send	80	130
Sand of amount	230	255
2		7.0
	<del>  .                                     </del>	1
	<b>1</b>	+
	<del>                                     </del>	1
	<del> </del>	1
	<del> </del>	<del> </del>
	<del> </del>	<del></del>
	<del>                                     </del>	+
<u> </u>		

If more than one screen, show location of each on sketch

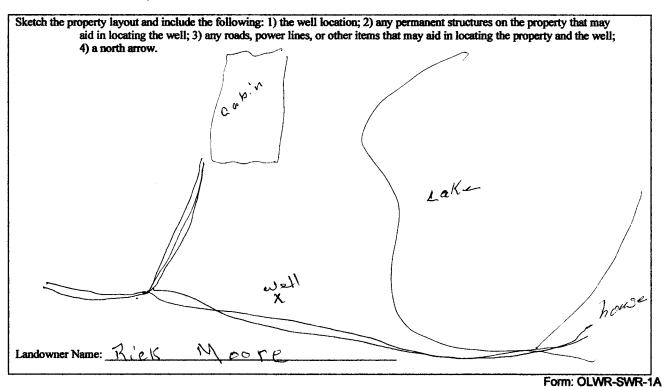

I certify that the well/borehole was drilled, constructed, and completed in accordance with all applicable requirements of the Mississippi Department of Environmental Quality and the Mississippi Department of Health regulations, if applicable, and state

Print Name of Responsible Licensee and License No.

Date

Signature of Licensee

# STATE WELL REPORT

# County: FTA WAMBA

## Part 2

Pump Installer's Completion Report Mississippi Department of Environmental Quality Office of Land and Water Resources P.O. Box 10631 Jackson, MS 39289-0631 (601)961-5210

For Office Use Only:		
Aquifer:		
Well #:	27	
Elevation:		

(601)354-6938 (fax) Copy information from block on Part 1 This part of the report must be completed by a licensed water well contractor or a licensed pump installer. A copy of Part 1 of the report must be attached and both parts filed with the Department at the above address within 30 days of well completion. Well Owner Information Well Location Owner Name: RICK MODRE Latitude: Longitude: Mailing Address: 4433 White SPRings Method of Lat/Long (check one): Conventional Survey\_\_\_\_, USGS quad , Hand-held GPS , Survey-grade GPS 5N 1/ R51 Sec 28 1/05 R 9E Direction Distance Negrest Town Telephone No. (\_\_\_\_) \_\_Miles \_\_\_\_\_ of \_\_\_\_ Power Type Pump Type Circle one Circle one Air Lift Diesel Engine Gasoline Engine Natural Gas Jet Submersible **Piston Bucket** Electric Motor Hand Tractor PTO Turbine Centrifugal Flowing Well Windmill Other (specify): Rotary Other (specify): Horse Power Rating of Motor: Setting Depth: \_\_\_\_\_\_\_feet Date Pump Installed: Rated Pump Capacity: Gallons Per Minute Number of Stages: Pump Test Data Method of Measuring Water Level Circle one Date Well Tested: Air Line Electric Measuring Line Static Water Level (A): \_\_\_\_\_Feet Below Land Surface Other (specify): Pumping Water Level (B): \_\_\_\_\_Feet Below Land Surface Drawdown [(B) - (A)]: \_\_\_\_\_\_Feet Below Land Surface For flowing well, measured shut in head: feet Test Pumping Rate: #350 Gallons Per Minute Well yielded GPM with a drawdown of feet after \_\_\_\_\_hours of pumping Duration of Pump Test (minimum 4 hours): 6 hours I HEREBY CERTIFY that the above statements are true to the best of my knowledge. Homas assi

Tho mas Ross U-509
Print Name of Pump Installer and License No. (if applicable) Signature of Pump Installer M-OLWR-SWR-1B