

ITAWAMBA MISSISSIPPI BOARD OF WATER COMMISSIONERS

M 4

7-11-60 CODED WATER WELL DRILLERS LOG

M 4  
M300

Date: 7-11, 1960, Driller: W. J. REEVES & SON County ITAWAMBA

5

(Name)

ITAWAMBA

(1) Owner of Land: <u>ITAWAMBA MFG. CO.</u> (Name)	Description & Color of Materials Sand, Clay, Red Clay, Shell, etc.	Thick- ness Feet	Depth Feet
<u>TREMONT, MISS.</u> (Address)	<u>RED CLAY</u>	<u>10</u>	<u>0-</u>
(2) Location: <u>SW 1/4, NW 1/4, Sec. 10 T12 R10 E</u>	<u>SAND &amp; GRAVEL</u>	<u>61</u>	<u>10</u>
<u>0</u> miles, of <u>TREMONT</u> (distance) (direction) (Nearest Town)			
(3) Topography: <u>HILLY</u> (Hilly) (Flat) (Level)			
(4) Purpose of Well: <u>INDUSTRIAL</u> (Domestic Irrigation Municipal, Industrial, Other)			

Information upon completion of well:

(1) Diameter 4 inches.

(2) Total Depth 71 feet.

(3) Water Level 23 feet below top of ground.

(4) Cased to 61', Size 4"


(5) Screen: Size 4", Length 10'

(6) Were any formations sealed against pollution?  
 yes,  no.

If YES depth of formation \_\_\_\_\_

Why \_\_\_\_\_

Drillers Remarks: \_\_\_\_\_

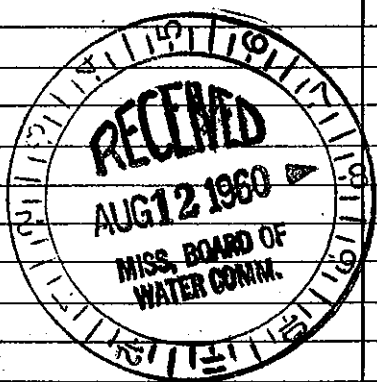

F 25

(Use Back Side)

Well No.  
M300

Mail this copy to Board of Water Commissioners 429 Miss. St. Jackson, Miss.