

ITAWAMBA MISSISSIPPI BOARD OF WATER COMMISSIONERS.

N 15

CODED

6-10-64

WATER WELL DRILLERS LOG CODED

Date: 6-10, 1964, Driller: HERNDON WELL & SUPPLY CO. County: Itawamba

5 2ND RD ON L P O BOX 12 SHANNON, MISSISSIPPI

(1) Owner of Land:	Description & Color of Materials Sand, Clay, Red Clay, Shell, etc.	Thick- ness Feet	Depth Feet
<u>G.E. Patterson</u> (Name)	<u>surface mud</u>		<u>0</u>
<u>At 2 Dorsey Miss</u> (Address)	<u>to clay</u>		
(2) Location: <u>NW 1/4, SE 1/4, Sec. 11, T. 158, R. 9632415</u> miles _____, of <u>Evergreen</u> (distance) (direction) (Nearest Town)	<u>Blue water</u>		<u>7.5</u>
(3) Topography: <u>Flat</u> (Hilly) (Flat) (Level)	<u>sand</u>		<u>90</u>
(4) Purpose of Well: <u>Domestic</u> (Domestic Irrigation, Municipal, Industrial, Other)	<u>to</u>		

Bottom 130

Information upon completion of well:

- (1) Diameter 4 inches.
- (2) Total Depth 130 feet.
- (3) Water Level 90 feet below top of ground.
- (4) Cased to 125', Size 4".
- (5) Screen: Size 4", Length 5'.
- (6) Were any formations sealed against pollution?
 yes, _____ no.
- If YES depth of formation 25'


CODED

Why surface & sand

Drillers Remarks: plastic casing & screen

Patterson Dracery

I 27

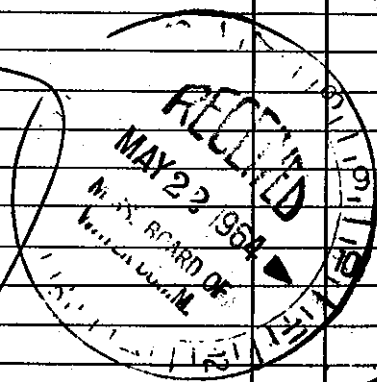

Well No.

(Use Back Side)

Mail this copy to Board of Water Commissioners: 429 Miss. St. Jackson, Miss.