

ITAWAMBA MISSISSIPPI BOARD OF WATER COMMISSIONERS

N 16

7-1-65


CODED

WATER WELL DRILLERS LOG

CODED

Herdon-Homan Well & Supply, Inc.

Date: July 1, 1965, Driller: SHANNON P. O. Box 42 County ITAWAMBA  
(Name) (Mississippi) 38865

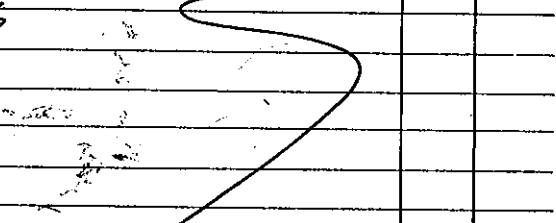(1) Owner of Land: <u>Hershel Wiggall</u> <small>(Name)</small>	Description & Color of Materials Sand, Clay, Red Clay, Shell, etc.	Thick- ness Feet	Depth Feet
<u>At Nettles, Miss.</u> <small>(Address)</small>	<u>surface sand &amp; clay</u>		<u>0-28</u>
(2) Location: <u>SW 1/4, NE 1/4, Sec. 17 T. 11 S. R. 6 E.</u> <u>CAROLINA</u> miles _____, of <u>Community</u> <small>(distance) (direction) (Nearest Town)</small>	<u>Blue clay</u>		<u>28-35</u>
(3) Topography: <u>Hilly</u> <small>(Hilly) (Flat) (Level)</small>	<u>Sand</u>		<u>35-120</u>
(4) Purpose of Well: <u>Chicken House</u> <small>(Domestic Irrigation Municipal, Industrial, Other)</small>			

Information upon completion of well:


- (1) Diameter 4 inches.
- (2) Total Depth 120 feet.
- (3) Water Level 10' feet below top of ground.
- (4) Cased to 30' 9", Size 4"
- (5) Screen: Size \_\_\_\_\_, Length \_\_\_\_\_
- (6) Were any formations sealed against pollution?  
 yes, \_\_\_\_\_ no.

If YES depth of formation 24'

Why Surface & sand

Drillers Remarks: \_\_\_\_\_

CODED

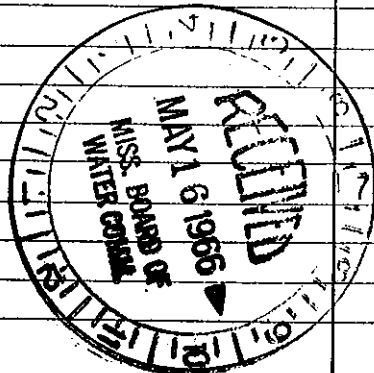

(Use Back Side)

Well No.

I 28

Retain this copy for your office files.