

ITAWAMBA MISSISSIPPI BOARD OF WATER COMMISSIONERS

N 17
7-5-65

CODED

WATER WELL DRILLERS LOG

CODED

Herndon-Homan Well & Supply, Inc.

Date: July 5, 1965, Driller: SHANNON, (Name) P. O. Box 42 County Itawamba
MISSISSIPPI 38868

(1) Owner of Land: <u>F. F. Boozer</u> (Name)	Description & Color of Materials Sand, Clay, Red Clay, Shell, etc.	Thick- ness Feet	Depth Feet
<u>Nettleton, Miss</u> (Address)	<u>uniform clay</u>	<u>2-30</u>	<u>30</u>
<u>9632888</u> (Address)	<u>blue clay</u>	<u>30</u>	<u>100</u>
(2) Location: <u>NW 1/4, Sec. 6, T. 15N, R. 22E</u> (distance) <u>2</u> miles <u>E</u> (direction), of <u>Evans</u> (Nearest Town)	<u>sand</u>	<u>100</u>	<u>128</u>
(3) Topography: <u>Hilly</u> (Hilly) (Flat) (Level)	<u>Bottom</u>		
(4) Purpose of Well: <u>Domestic</u> (Domestic Irrigation Municipal, Industrial, Other)			

Information upon completion of well:


- (1) Diameter 4 inches.
- (2) Total Depth 135' feet.
- (3) Water Level 60 feet below top of ground.
- (4) Cased to 124', Size 4".
- (5) Screen: Size 4", Length 5'.
- (6) Were any formations sealed against pollution?
 yes, no.

If YES depth of formation 100'

Why uniform & sand

Drillers Remarks: Plastic casing
& screen

CODED

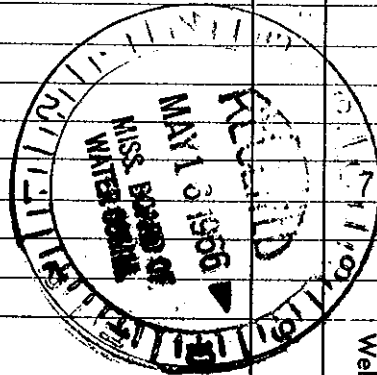

I 29

Well No.

(Use Back Side)

Retain this copy for your office files.