

ITAWAMBA
N 18
2-67

MISSISSIPPI BOARD OF WATER COMMISSION

CODED
CODED
CODED
CODED

WATER WELL DRILLERS LOG

Date: Feb 28, 1967, Driller: Merndon-Noman Well & Supply, Inc.
P.O. Box 42 County ITAWAMBA
(When well drilled) SHANNON, MISSISSIPPI 38868 (Where well is located)

(1) Owner of Land: Alvin Hood
(Name)
Rt 1 Nettleton, Miss
9632458 5F (Address)
NE NW
(2) Location: 1/4, 2/4, 3/4, Sec. 7, T11 S, R2E
3/4 miles SE, of Evergreen
(distance) (direction) (Nearest town)
(3) Topography: Flat
(Hilly) (Flat) (Level)
(4) Purpose of Well: Home
(Domestic Irrigation
Municipal, Industrial, Other)


Description & Color of Materials Sand, Clay, Red Clay, Shell, etc.	Thick- ness Feet	Depth Feet
super sand	0	20
clay	20	90
Blue clay	90	120
Sand	90	120
both	120	

Information upon completion of well:

(1) Diameter 4 inches.
(2) Total Depth 120 feet.
(3) Water Level 90 feet below top of ground.
(4) Cased to 115', Size 4" PVC
PVC
(5) Screen: Size 4", Length 5'
(6) Were any formations sealed against pollution?
yes, no.

CODED

If YES depth of formation 90
Why super sand
Drillers Remarks:
Yield in gpm: by other
Size pump:
Type power:

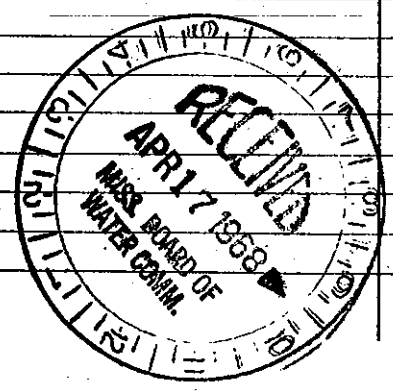

Retain this copy for your office files.