

TAWAMBA
N 19
10-67

MISSISSIPPI
BOARD OF WATER COMMISSIONERS
416 North State Street
Jackson, Mississippi 39201

CODED
CODED
CODED
CODED

WATER WELL DRILLERS LOG

10/25/67 Herndon-Homan Well & Supply, Inc. Tawamba
date well completed P. O. Box 42
SEANNON, MISSISSIPPI 38868 county well located

LANDOWNER:
David C. Weeks
Rt 2 Nettleton
(mailing address)


description of formations encountered	from	to
surface sand	0	40
blue clay	40	100
gravel	100	200
bed	200	

WELL LOCATION:
sec. 14 T. 11 N. R. 7 E
S W
2 miles SW of Evergreen
(distance) (direction) (nearest town)

WELL PURPOSE: Chicken House
(home, irrigation, municipal, industrial)

- WELL COMPLETION DATA:
- (1) diameter (inches) 4"
 - (2) total depth (feet) 200'
 - (3) static water level (feet) 75' below top of ground
 - (4) casing Steel 45' 8"
(material) (depth)
 - (size) if telescope see back.
 - (5) screen No
(length) (depth to top)
 - (size) (material)
 - (6) pump 1/2 200 gph
(HP) (yield gph)
electric
(type power)
 - (7) electric log No
(yes or no)
 - (organization running log)
 - (8) how well bottom plugged open

CODED

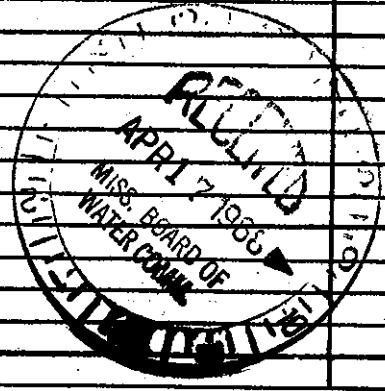

DRILLERS REMARKS: