

ITAWAMBA MISSISSIPPI BOARD OF WATER COMMISSIONERS

09
10-21-60

CODED

WATER WELL DRILLERS LOG

CODED

P 300

Date: 10-21, 1960, Driller: W. TREVES & SON County: ITAWAMBA

(Name)

(1) Owner of Land: PRENTISS KENNEDY
(Name)

SMITHVILLE, MISS
(Address)

(2) Location: E 1/2 NW 1/4, Sec. 8 T11 R9 E

5 miles N of SMITHVILLE
(distance) (direction) (Nearest Town)

(3) Topography: HILLY
(Hilly) (Flat) (Level)

(4) Purpose of Well: DOMESTIC
(Domestic Irrigation
Municipal, Industrial, Other)

Description & Color of Materials Sand, Clay, Red Clay, Shell, etc.	Thick- ness Feet	Depth Feet
CLAY	15	0
WHITE SAND	2	15
CLAY	43	17
SAND	28	60

Information upon completion of well:

(1) Diameter: 2 1/2 inches.

(2) Total Depth: 88 feet.

(3) Water Level: 12 feet below top of ground.

(4) Cased to: 83', Size: 2 1/2"


(5) Screen: Size: 2 1/2", Length: 5'

(6) Were any formations sealed against pollution?
yes, no.

If YES depth of formation _____

Why _____

Drillers Remarks: _____

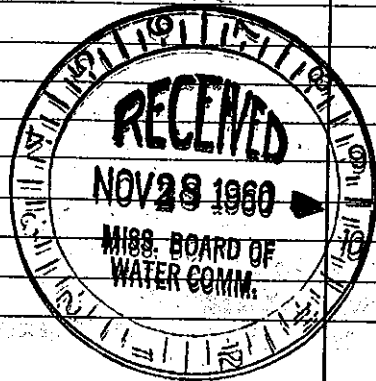

(Use Back Side)

Well No.

130

Mail this copy to Board of Water Commissioners 429 Miss. St. Jackson, Miss