

JACKSON

A 17

6-68

MISSISSIPPI
BOARD OF WATER COMMISSIONERS
416 North State Street
Jackson, Mississippi 39201

WATER WELL DRILLERS' LOG

June 1 1968 L.L. Garland water wells Jackson
date well completed firm name county well located

LANDOWNER: J.L. Enabinett

Rt. 2 Box 229

Ocean Springs, Miss
(mailing address)

WELL LOCATION:

sec. 2 T 4 N R 8 E
S W
15 miles north of O.S.
(distance) (direction) (nearest town)

WELL PURPOSE: home
(home, irrigation, municipal, industrial)

WELL COMPLETION DATA:

- (1) diameter (inches) 2
- (2) total depth (feet) 430
- (3) static water level (feet) 105 below above top of ground.
- (4) casing (material) (depth) (size) if telescope see back.
- (5) screen 10 ft (length) (depth to top) 2" (size) brass (material)
- (6) pump 1 hp (HP) (yield gpm) electric (type power)
- (7) electric log (yes or no) (organization running log)
- (8) how well bottom plugged w. valves

description of formations encountered


from to

JUN 4 1968
MISS. BOARD OF
WATER COMM.

DRILLERS REMARKS: 32 ft
water bearing sand

If well telescopes please sketch and show depths.

GROUND LEVEL

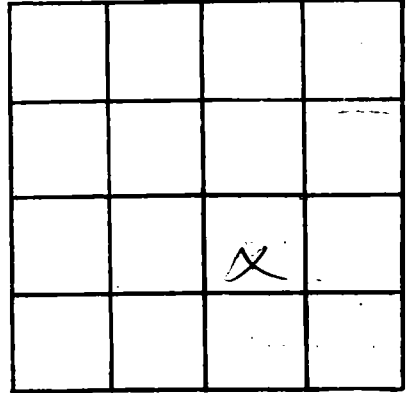

SECTION 2

Please indicate well location X.

ADDITIONAL INFORMATION

Lined area for additional information.

If more than one screen, show locations of each on sketch.