

Jackson
A 19
7-20-68

MISSISSIPPI
 BOARD OF WATER COMMISSIONERS
 416 North State Street
 Jackson, Mississippi 39201

CODED

WATER WELL DRILLERS LOG

7-20 19*68* *Coast Water Well Serv. Jackson*
 date well completed firm name county well located

LANDOWNER: *Vernon Byrd*

Route # 1 Box 288
Ocean Springs Miss.
 (mailing address)

description of formations encountered

	from	to
<i>Red Clay</i>	<i>0</i>	<i>23</i>
<i>Pink sandy clay</i>	<i>23</i>	<i>37</i>
<i>Blue clay</i>	<i>37</i>	<i>90</i>
<i>Sand med</i>	<i>90</i>	<i>115</i>

WELL LOCATION:

sec *21* T *4* N R *8* E
 S W
16 miles *N.W.* of *Vandeventer*
 (distance) (direction) (nearest town)

WELL PURPOSE: *Home*
 (home, irrigation, municipal, industrial)

WELL COMPLETION DATA:

- (1) diameter (inches) *2"*
- (2) total depth (feet) *113*
- (3) static water level (feet) *55'* below top of ground.
- (4) casing *Galv.* *105'*
 (material) (depth)
2"
 (size) if telescope see back.
- (5) screen *10* *105'*
 (length) (depth to top)
2" *wrapped Strips*
 (size) (material)
- (6) pump *1* *10*
 (HP) (yield gpm)
elec.
 (type power)
- (7) electric log *NO*
 (yes or no)

CODED

(organization running log)
 (8) how well bottom plugged *Back*
Wash Valve


DEC 30 1968

DRILLERS REMARKS:

MISS. BD. OF
 WATER COM.

If well telescopes please sketch and show depths.

GROUND LEVEL

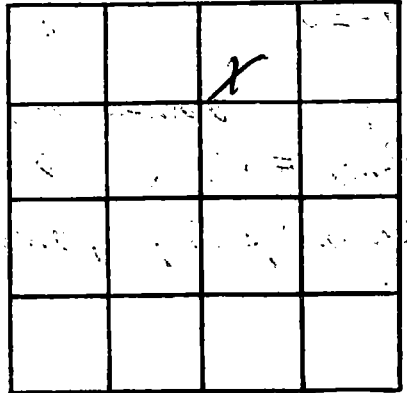

SECTION 21

Please indicate well location X.

ADDITIONAL INFORMATION

If more than one screen,
show locations of each on sketch.