

Jackson
A20
6-4-70

MISSISSIPPI
BOARD OF WATER COMMISSIONERS
416 North State Street
Jackson, Mississippi 39201

CODED

WATER WELL DRILLERS LOG

1970 6/4 date well completed
Mr. H. Kell Co. firm name
Jackson county well located

LANDOWNER: Frank Perkins
Perkinston Miss
 (mailing address)

description of formations encountered	from	to
Dirt	0	1
yellow clay	1	8
White clay	8	11
Sand	11	15
White clay	15	28
Blue clay	28	31
Sand	31	84
Blue clay	84	105
Blue clay & shale	105	111
Blue clay	111	212
Sand	212	241

WELL LOCATION:
 sec. 3 T. 4 N. R. 8 E.
0 miles (distance) of Westrey (direction) (nearest town)

WELL PURPOSE: Home
 (home, irrigation, municipal, industrial)

WELL COMPLETION DATA:

- (1) diameter (inches) 2"
- (2) total depth (feet) 241
- (3) static water level (feet) 0 below above top of ground.
- (4) casing Galv. 231
 (material) (depth)
 (size) if telescope see back.
- (5) screen 10' 231
 (length) (depth to top)
2" Plastic
 (size) (material)
- (6) pump Flouid 50
 (HP) (yield gpm)
 (type power)
- (7) electric log No
 (yes or no)
 (organization running log)
- (8) how well bottom plugged Back
Wash valve


CODED

JUN 15 1970

DRILLERS REMARKS:

If well telescopes please sketch and show depths.

GROUND LEVEL

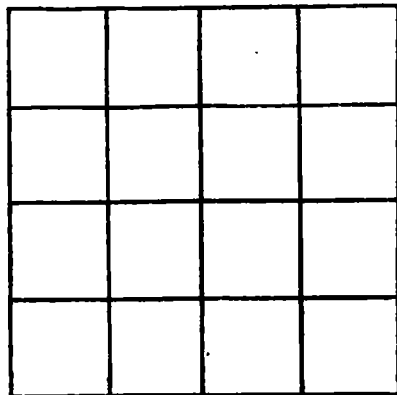

SECTION _____

Please indicate well location X.

ADDITIONAL INFORMATION

If more than one screen, show locations of each on sketch.