

Jackson
 A 21
 6-6-70

MISSISSIPPI
 BOARD OF WATER COMMISSIONERS
 416 North State Street
 Jackson, Mississippi 39201

CODED

WATER WELL DRILLERS LOG

6/6/70 date well completed 1970 M+H Well Co. firm name Jackson county well located

LANDOWNER: Bud Catlett

description of formations encountered	from	to
Dirt	0	2
yellow clay	2	8
white clay	8	15
blue clay	15	18
sand	18	68
blue clay	68	98
blue clay + shale	98	105
blue clay	105	180
sand	180	188
blue clay	188	247
silt sand	247	367
course sand	317	367

Perkinston Miss
 (mailing address)

WELL LOCATION:
 sec. 3 T. 4 N. R. 8 E
 0 miles (distance) of Western (direction) of (nearest town)

WELL PURPOSE: Home
 (home, irrigation, municipal, industrial)

WELL COMPLETION DATA:

- (1) diameter (inches) 2"
- (2) total depth (feet) 367
- (3) static water level (feet) 0 below top of ground.
- (4) casing 4" Galv. 357 (material) (depth)
- (size) if telescope see back.
- (5) screen 10ft 357 (length) (depth to top)
 2" Plastic (size) (material)
- (6) pump Flowed 50 (HP) (yield/gpm)
- (type power)
- (7) electric log No (yes or no)
- (organization running log)
- (8) how well bottom plugged Back Wash Valve


CODED

JUN 7 5 1970

DRILLERS REMARKS:

If well telescopes please sketch and show depths.

GROUND LEVEL

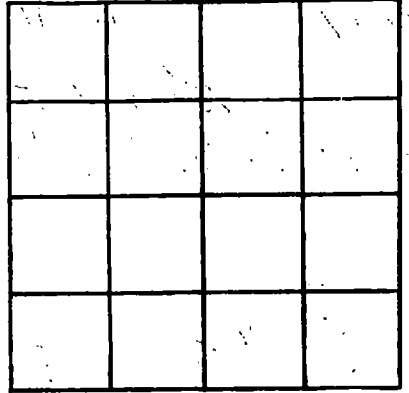

SECTION _____

Please indicate well location X.

ADDITIONAL INFORMATION

If more than one screen,
show locations of each on sketch.