

JACKSON  
A 24  
3-22-71

MISSISSIPPI  
BOARD OF WATER COMMISSIONERS  
416 North State Street  
Jackson, Mississippi 39201

**CODED**

WATER WELL DRILLERS LOG

3-22-71 date well completed 1971 Mr H Zell Co firm name Jackson county well located

LANDOWNER: Raymond Walker  
Perkinston Miss  
(mailing address)

WELL LOCATION:  
sec 2 T 4 N R 8 E  
1 miles E of Destiny  
(distance) (direction) (nearest town)

WELL PURPOSE: Home  
(home, irrigation, municipal, industrial)

WELL COMPLETION DATA:

(1) diameter (inches) 2"

(2) total depth (feet) 209

(3) static water level (feet) 0 below top of ground above

(4) casing Galv 199  
(material) (depth)

(size) If telescope see back.

(5) screen 10" 199  
(length) (depth to top)

2" Plastic  
(size) (material)

(6) pump 50  
(HP) (yield gpm)

(type power)

(7) electric log No  
(yes or no)

(organization running log)

(8) how well bottom plugged Back  
Wash valve

description of formations encountered	from to	
Dirt	0	1
White clay	1	11
Yellow clay	11	15
Sand	15	19
White clay	19	28
Blue clay	28	123
Dark Sand	123	128
Blue clay	128	184
Sand	184	209

**CODED**


MAR 24 1971

MISS. BD. OF  
WATER COM.

DRILLERS REMARKS:

If well telescopes please sketch and show depths.

GROUND LEVEL

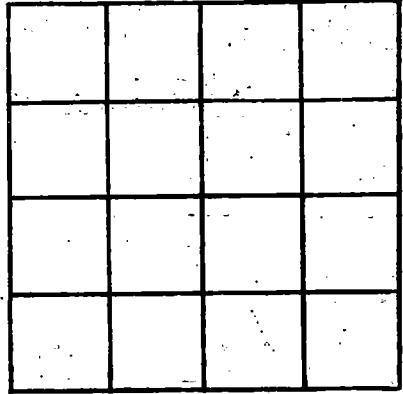

SECTION \_\_\_\_\_

Please indicate well location X.

ADDITIONAL INFORMATION

If more than one screen, show locations of each on sketch.