

JACKSON  
A30  
5-22-73

MISSISSIPPI  
BOARD OF WATER COMMISSIONERS  
416 North State Street  
Jackson, Mississippi 39201

CODED

WATER WELL DRILLERS LOG

Jackson  
~~Jefferson~~  
county well located

5-22 1973 data well completed  
Cahill Water Supply firm name  
county well located


LANDOWNER: <u>David</u>	description of formations encountered	from	to
<u>both</u>			
<u>Browne Ms.</u> (mailing address)	<u>clay</u> <u>sand &amp; gravel</u> <u>clay</u> <u>sand</u>	<u>0</u> <u>21</u> <u>90</u> <u>174</u> <u>174</u>	<u>21</u> <u>90</u> <u>174</u> <u>175</u>
<b>WELL LOCATION:</b>			
sec. <u>1</u> T. <u>4</u> N. R. <u>8</u> E. <u>15</u> miles <u>North</u> of <u>Dauchay</u> (distance) (direction) (nearest town)			
<b>WELL PURPOSE:</b> <u>home</u> (home, irrigation, municipal, industrial)			
<b>WELL COMPLETION DATA:</b>			
(1) diameter (inches) <u>2</u> "			
(2) total depth (feet) <u>195</u>			
(3) static water level (feet) <u>2</u> <u>below</u> <u>above</u> top of ground.			
(4) casing <u>galv</u> <u>190</u> (material) (depth)			
(size) if telescope see back.			
(5) screen <u>5</u> <u>190</u> (length) (depth to top)			
<u>2</u> " <u>stain</u> (size) (material)			
(6) pump <u>1/2</u> <u>8</u> (HP) (yield gpm)			
<u>elec</u> (type power)			
(7) electric log <u>no</u> (yes or no)			
(organization running log)			
(8) how well bottom plugged <u>BP Valve</u>			
DRILLERS REMARKS:			

CODED

DEC 21 '74

If well telescopes please sketch and show depths.

GROUND LEVEL

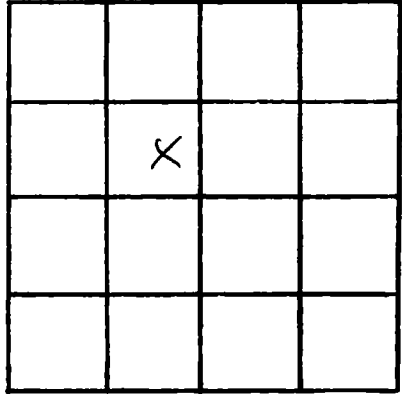

SECTION   /  

Please indicate well location X.

ADDITIONAL INFORMATION

If more than one screen, show locations of each on sketch.