

JACKSON
A31
6-7-74

MISSISSIPPI
BOARD OF WATER COMMISSIONERS **CODED**
416 North State Street
Jackson, Mississippi 39201

WATER WELL DRILLERS LOG

6, 7, 1974 *M & H Well Co Jackson*
date well completed firm name county well located

LANDOWNER: *Wallace Perkin*
Perkinson Truss
(mailing address)

description of formations encountered	from	to
Dirt	0	2
Red	2	6
yellow clay	6	13
Sand	13	18
Blue clay	18	74
Silk sand	74	168
Blue clay	168	174
Silk sand	174	221
Silk sand	221	235
Course Sand	235	247

WELL LOCATION:
sec. 3 T 4 N R 8 E
0 miles of Westery
(distance) (direction) (nearest town)

WELL PURPOSE: Home
(home, irrigation, municipal, industrial)

WELL COMPLETION DATA:

(1) diameter (inches) 2"

(2) total depth (feet) 247

(3) static water level (feet) 0 below top of ground. above

(4) casing Galv. 195
(material) (depth)

_____ If telescope see back.
(size)

(5) screen none 105
(length) (depth to top)

_____ (size) _____ (material)

(6) pump _____ (HP) 30 (yield/gpm)


_____ (type power)

(7) electric log _____ (yes or no)

_____ (organization running log)

(8) how well bottom plugged none

CODED

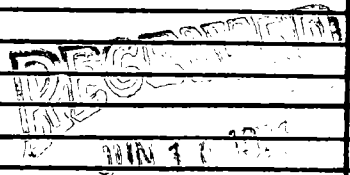

DRILLERS REMARKS:
Over

MISS. B.D. ...

