

MISSISSIPPI DEPARTMENT OF NATURAL RESOURCES

Bureau of Land and Water Resources


Southport Mall

P.O. Box 10631

Jackson, Mississippi 39209

WATER WELL DRILLERS LOG

Griner Drilling Service, Inc.

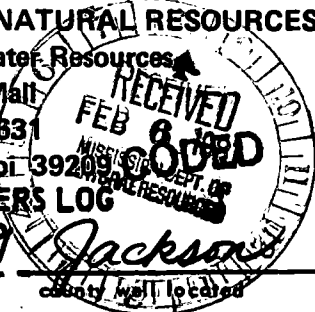

Jackson
A.34
1-24-81

date well completed

firm name

county well located

LANDOWNER	description of formations encountered	from	to
Champlin Petroleum 300 Phumos 236 East Capital Jackson, Ms. (mailing address)	clay, chalk	0	21
	chalk	21	147
WELL LOCATION: 1853' S + 198' E sec. 13 T 4 N R 8 E of NW 1/4 North of Vandave (distance) (direction) (nearest town)	sand, chalk	147	168
	chalk	168	252
WELL PURPOSE: oil field (home, irrigation, municipal, industrial) supply	streaked	252	525
WELL COMPLETION DATA:	sand	525	588
(1) diameter (inches) 3"	streaked	588	609
(2) total depth (feet) 609'			
(3) static water level (feet) 100' below top of ground.			
(4) casing steel, 588' (material) (depth)			
3" If telescope see back. (size)			
(5) screen 42', 546' (length) (depth to top)			
3" perforated (size) (material)			
(6) pump — 75 (HP) (yield gpm)			
ac (type power)			
(7) electric log — (yes or no)			
— (organization running log)			
(8) how well bottom plugged orange peel			
DRILLERS REMARKS:			

If well telescopes please sketch and show depths.

CODED

GROUND LEVEL

SECTION _____

Please indicate well location X.

ADDITIONAL INFORMATION

If more than one screen, show locations of each on sketch.