

MISSISSIPPI DEPARTMENT OF NATURAL RESOURCES

Bureau of Land and Water Resources

Southport Mall

P.O. Box 10631

Jackson, Mississippi 39209

WATER WELL DRILLERS LOG

CODED

JACKSON  
A 38  
6-14-84

6-14 date well completed 1984 Coast Water Well Sew. firm name Jackson county well located

LANDOWNER:	description of formations encountered	from	to
Edgar Talbott 5713 Southland Dr. Ocean Springs, Miss (mailing address) 37564	Top Soil	0	3
WELL LOCATION: sec. 23 T. 4 N. R. 8 E 11 miles NW of Vanclave (distance) (direction) (nearest town)	Red Clay	3	18
WELL PURPOSE: (home, irrigation, municipal, industrial)	Blue Clay	18	174
WELL COMPLETION DATA: (1) diameter (inches) 2" (2) total depth (feet) 620' (3) static water level (feet) 68' below top of ground. (4) casing PVC, 600' (material) (depth) 2" (size) if telescope see back. (5) screen 10' (length), 600' (depth to top) 2" PVC (size) (material) (6) pump 1 1/2 HP (HP), 7 (yield gpm) Elev. (type power) (7) electric log No (yes or no) (organization running log) (8) how well bottom plugged Backwash valve	White Fine Sand + wood	174	199
	Blue Clay + Shale of Sand	199	255
	Blue Clay	255	540
	Gray Fine Sand	540	590
	Gray Coarse Sand	590	610
	Gray Coarse Sand + Gravel	610	617
	Blue Clay	617	620
	10' x 2" PVC tail pipe	610	620

DEPT. OF NATURAL RESOURCES  
BUREAU OF LAND & WATER RESOURCES


JUN 10 1984

RECEIVED

DRILLERS REMARKS:

If well telescopes please sketch and show depths.

GROUND LEVEL

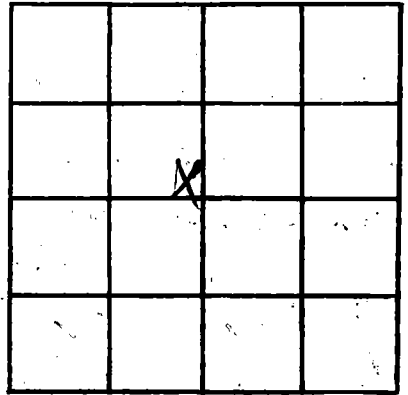

SECTION 23

Please indicate well location X.

ADDITIONAL INFORMATION

If more than one screen, show locations of each on sketch.