State Well Report				
county: Jackson	Part 1	For Office Use Only:		
Mississippi Dep	artment of Environmental Quality	Aquifer:		
Permit #: Office of	Land and Water Resources	Well #: <u>A-72</u>		
Driller: Coast Water WellSru Iac	P.O. Box 10631 kson, MS 39289-0631	L. S. Elevation:		
Date drilling completed: 4-22-05	(601)961-5210	L. S. Elevation:		
	601)354-6938 (fax)	E-log #:		
State Law requires that this report be prepared by the driller in detail and filed with the Department within 30 days of completion of drilling of the well.				
Well Owner Information	Wei	Il Location		
Owner Name_Kay Williams	Latitude: <u>30 • 39 · //0</u>	_" Longitude: <u>088° 46 '522</u> " 31		
Mailing Address: Wire Rd	Method of Lat/Long (circle o			
USGS quad, Hand-held GPS Survey-grade GPS		d GPS Survey-grade GPS		
Vancleave MS 3956	Vancleave MS 39565 Sw 1/ SE 1/ Sec 34 City State Zip Code			
Telephone No. (208 826-2160	Distance Direction	Nearest Town of <u>Awcleave</u>		
	Well Data			
		01		
Purpose of Well (circle one) (Home) Industrial Public Su		Other:		
Date well drilling started: $4 - 21 - 05$ Date well drilling completed: $4 - 22 - 05$				
If flowing, method of flow regulation: Valve N/A Other (describe)				
Static Water Level: 130feet above or below circle one) land surface Date measured: 4-22-05				
Method of Measurement (circle one) steel tape electric tape air line other:				
Hole depth: <u>588</u> Well depth: <u>588</u> Well grouted to a depth of <u>10</u> feet				
Type of grout (circle one): Cement Bentonite Mix				
Casing length: 573 feet Casing diameter: inches Type of casing: $\rho V $				
Screen length: <u>15</u> feet Screen diameter: <u>2</u> inches Type of screen: <u>PVC</u>				
Screen slot size: . 006 inches Setting depth: From 573 feet to 588 feet				
Type of completion (circle all applicable): Gravel packed Underreamed Telescoped Open hole Natural Development				
Other (describe):				
Top of lap pipe or reduction in casing:	t. If telescoped or more than one scr	een, describe on back of page		
Logs run (circle all applicable): No log run Electric Gamma Ray Density Sonic Neutron Other:				
Name of organization running log(s): I certify that the well was drilled, constructed, and completed in accordance with all applicable requirements of the Mississippi				
Department of Environmental Quality and/or the Mississippi Department of Health regulations and state laws.				
JackRidgdell 0-472 Chap Refueld				
Print Name of Water Well Contractor and License No.	Signature of	Water Well Contractor		
		MAY 0 2 2005		

,

•5

MAY 8 2 2005 BY: OLW/R


If well telescopes please sketch below and show depths.

Ground Level

•	Ar 12		
	Description of Formations Encountered	From	То
	 TODSnil	0	\mathcal{A}
	Drange, Clay	a	26
-	Brown Charse, Sand	26	40
	Blueclan	40	520
	Gray medium + Coarse Sand	520	588
	-1 un Inpersion come - com		
			\square
		L	L

۸

If more than one screen, show location of each on sketch

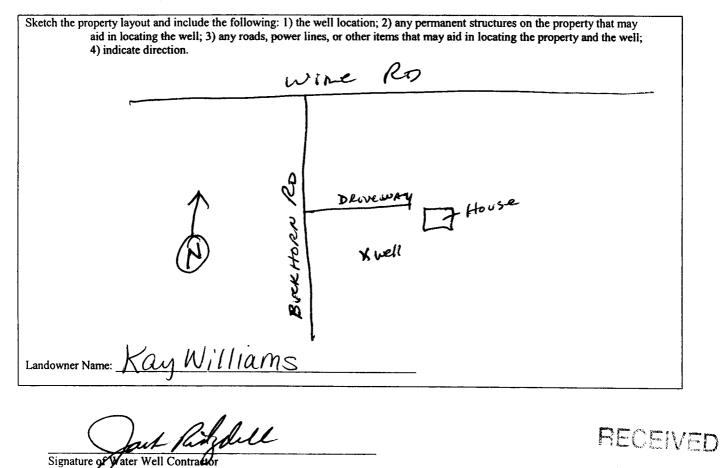

MAY 0 2 2035 BY: OLWFI

STATE WELL REPORT				
County: Jackson Pump Installer Permit #: Mississippi Departme Driller COAST WOHLY WILLSTV Office of Land Driller COAST WOHLY WILLSTV Jackson, Data completed: 4-22-05 (601	Part 2 For Office Use Only: 's Completion Report Aquifer: and Water Resources Ms 39289-0631 Box 10631 Well #: A- 72 ()961-5210 Elevation:			
This report should be prepared by the pump installer in detail and filed with the Department within 30 days of the				
installation of pump. Well Owner Information				
Owner Name: <u>Kay Williams</u> Mailing Address: <u>BUS by RO</u>	Latitude: 30° 39' / / 0" Longitude: 088° 46 522"			
Mailing Address: TBUS by Rd	Method of Lat/Long (circle one): Conventional Survey,			
	USGS quad, Hand-held GPS Survey-grade GPS			
Vancleave, MS 39565 City State Zip Code	Swy SE 1/2 Sec_ 34 Twn T45 Rng R8W			
City State Zip Code	Distance Direction Nearest Town			
Telephone No. (208) 826 - 2160	10 Miles NW of VANcleave			
Pump Type Circle one	Power Type Circle one			
Air Lift Jet Submersible	Diesel Engine Gasoline Engine Natural Gas			
Bucket Piston Turbine	Electric Motor Hand Tractor PTO			
Centrifugal Rotary Flowing Well	Windmill Other (specify):			
Other (specify): 2 HP Goulds	Horse Power Rating of Motor: 2 HP Gould			
Date Pump Installed: 4-25-05	Setting Depth: 150FT. DOPPIPE_feet			
Rated Pump Capacity: Gallons Per Minute	Number of Stages:3			
Pump Test Data	Method of Measuring Water Level			
Date Well Tested: <u>4-25-05</u>	Circle one			
Static Water Level (A): 730 Feet Below Land Surface	Air Line Electric Measuring Line Steel Tape			
Pumping Water Level (B): <u>NA</u> Feet Below Land Surface	Other (specify):			
Drawdown [(B) – (A)]: N/A Feet Below Land Surface	For flowing well, measured shut in head://Afeet			
Test Pumping Rate: Gallons Per Minute	Well yielded GPM with a drawdown of			
Duration of Pump Test (minimum 4 hours): hours hours N/H feet after N/H hours of pumping				
I HEREBY CERTIFY that the above statements are true to the best of my knowledge.				
Print Name of Pump Installer and License No. (if applicable)	Signature of Pump Installer			

•

~

BECEIVED MAY 0 2 2005 BY: OLWR