State Well Report							
	art 1	For Office Use Only:					
Mississippi Departmen	t of Environmental Quality and Water Resources	Aquifer:					
	Box 10631	Well #: <u>A- 74</u>					
Jackson, IV	IS 39289-0631	L. S. Elevation:					
	961-5210 4-6938 (fax)	E-log #:					
State Law requires that this report be prepared by the 30 days of completion of drilling of the well.	driller in detail and filed w	ith the Department within					
Well Owner Information	Well	Location					
Owner Name WOOdy'S OUTPOST	Latitude: 30 • 41 .962	2" Longitude <u>(88° 44 , 418</u> , ne): Conventional Survey, <b>25</b>					
Mailing Address: <u>24601 Hwy 57</u>	Method of Lat/Long (circle or	ne): Conventional Survey,					
	USGS quad, Hand-held	GPS Survey-grade GPS					
Vancleave MS 39565 City State Zip Code	SW 1/4 NE 1/4 Sec_ 13	Twn T45 Rng R8W					
Telephone No. $\partial \partial S \partial S \partial b - 5179$	Distance Direction	Nearest Town of Vanceare					
Well	Data						
Purpose of Well (circle one) Home Industrial Public Supply	Irrigation Fish Culture	Other:					
Date well drilling started: $4 - 26 - 05$ Date well drilling completed: $4 - 27 - 05$							
If flowing, method of flow regulation: Valve Other (describe)							
Static Water Level: 100' feet above or below (circle one) land surface Date measured: 4-27-05							
Method of Measurement (circle one) steel tape electric tape air line other:							
Hole depth: 164' Well depth: 164' Well grouted to a depth of 10 feet							
Type of grout (circle one): Cement Bentonite Mix							
Casing length: <u>149</u> feet Casing diameter: <u>2</u>	inches Type of casing:	PUC					
Screen length: <u>15</u> feet Screen diameter: <u>2</u> inches Type of screen: <u>PUC</u>							
Screen slot size: <u>. 006</u> inches Setting depth: From <u>149</u> feet to <u>164</u> feet							
Type of completion (circle all applicable): Gravel packed Underreamed Telescoped Open hole Natural Development							
Other (describe):							
Top of lap pipe or reduction in casing:							
Logs run (circle all applicable) No log run Electric Gamma Ray Density Sonic Neutron Other:							
Name of organization running log(s):							
I certify that the well was drilled, constructed, and completed in accordance with all applicable requirements of the Mississippi Department of Environmental Quality and/or the Mississippi Department of Health regulations and state laws.							
JACK Ridodell 0-472	$\sim$	Robert					
Print Name of Water Well Contractor and License No.	Signature of	Water Well Contractor					
L	<i>[]</i>	HECEIVED					

MAY 2 5 2005 BY: OLWR If well telescopes please sketch below and show depths.

Grou


, '

nd Level	Description of Formations Encountered	From	To
	 TOP Soll on	$\bigcirc$	2
	Orange, + Blue Clay	A	13
	Gray Marse Sand	127	TH
	The contraction of the contracti		-
1			L
	······		
			—
	······································		
		······	· · · · · · ·

フリ

Λ

If more than one screen, show location of each on sketch

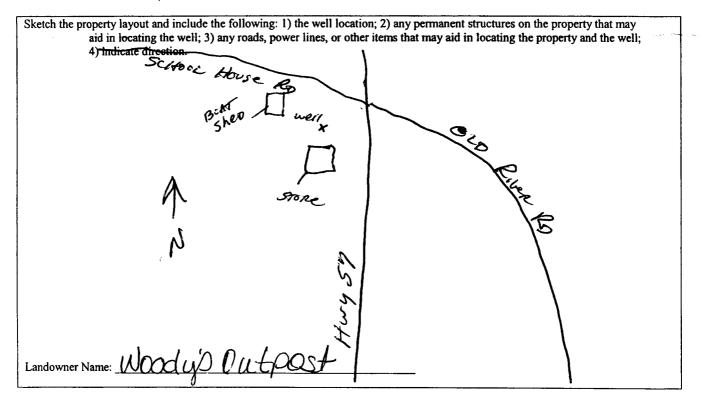

e of Water Well Contractor Signatur

RECEIVED MAY 2 5 2005 BY: OLWR

STATE WELL REPORT							
County: JACKSON Permit #: Driller: COASH WAHLY WELLSOV Date completed: <u>4-27-05</u>	Part 2 Pump Installer's Completion Report Mississippi Department of Environmental Quality Office of Land and Water Resources P.O. Box 10631 Jackson, MS 39289-0631 (601)961-5210 (601)354-6938 (fax)		Aquifer: Well #: A	e Use Only:			
This report should be prepared by th installation of pump.	This report should be prepared by the pump installer in detail and filed with the Department within 30 days of the installation of nump						
Well Owner Informat Owner Name: Wood yo Outf		W Latitude: <u>30°41'96</u>	/ell Location 3 <sup>#</sup> Longitude: <u>080</u>	3°44'418"			
Mailing Address: <u>24601 HWY.</u>	57 Method of Lat/Long (circle on		one): Conventional	Survey,			
Vanc leave N City State	Zip Code	USGS quad, Hand-held GPS Survey-grade GPS <u>5</u> <u>14</u> <u>NE</u> <u>14</u> Sec <u>13</u> Twn <u>T4S</u> Rng <u>R8</u> <u>W</u> Distance Direction Nearest Town <u>12.5 Miles</u> <u>Northof</u> <u>Awcleave</u>					
	- <b></b>						
Pump Type Circle one			Power Type Circle one				
Air Lift Jet	Submersible	Diesel Engine Gaso	line Engine	Natural Gas			
Bucket Piston	Turbine	Electric Motor Hand	d	Tractor PTO			
Centrifugal Rotary	Flowing Well	Windmill Othe	er (specify):				
Other (specify): Date Pump Installed: Rated Pump Capacity: 8.5		Horse Power Rating of Mot Setting Depth: <u>/@OFT</u> Number of Stages:	Droppipe				
Pump Test Data			leasuring Water L	evel			
Date Well Tested: <u><u>4-28-05</u> Static Water Level (A): <u>100</u> Feet Pumping Water Level (B): <u>NIA</u> Feet F</u>	Below Land Surface Below Land Surface	Air Line Electric Ma Other (specify):	Circle one easuring Line	Steel Tape			
Drawdown [(B) – (A)]: A Feet Below Land Surface For flowing well, measured shut in head:			•				
Test Pumping Rate: <b>8,5</b> Duration of Pump Test (minimum 4 hours):	1	Well yielded <u>8.5</u> <u>N/A</u> feet after					
I HEREBY CERTIFY that the above statem <u>JACK Ridgdell</u> Print Name of Pump Installer and License N	7-472	f my knowledge. Signature of Pump	Riddell	RECEIVED			
				MAY 2 5 2005			

. . . .

BY: OLWR