	State W	ell Report	 1		
County: Jackson		art 1	For Office Use Only:		
Permit #:		t of Environmental Quality	Aquifer:		
		nd Water Resources Box 10631	Well #: <u>A-88</u>		
Driller (Dast Water Well STV.	Jackson, M	IS 39289-0631	L. S. Elevation:		
Date drilling completed: 7-20-00		961-5210 4-6938 (fax)	E-log #:		
L					
State Law requires that this rep 30 days of completion of drilling		driller in detail and filed w	vith the Department within		
Well Owner Informs		Wel	Location		
Owner Name EMILE Babin	_ / ` `	Latitude: 30 • 38 831	" Longitude: 088 49,340		
Mailing Address: DESOTO BUH	2	Method of Lat/Long (circle or	ne): Conventional Survey,		
Lot 13		USGS quad, Hand-held	GPS, Survey-grade GPS		
vancleave M	<u>) 5 39565</u> te Zip Code	SE 1/ SW 1/ Sec 21	Twn 7 45 Rng R8W		
Telephone No. 228 345- 54	-	Distance Direction	of <u>VANCEAUE</u>		
	Well I	l Data			
Purpose of Well (circle one) Home Ind	ustrial Public Supply	Irrigation Fish Culture	Other:		
Purpose of Well (circle one Home) Industrial Public Supply Irrigation Fish Culture Other: Date well drilling started: $7 - 20 - 00$ Date well drilling completed: $7 - 20 - 00$					
If flowing, method of flow regulation: Va			•		
Static Water Level: feet at	pove orbelow (circle one)	and surface Date measured:	7-20-06		
Method of Measurement (circle one) steel tape electric tape air line other:					
Hole depth: <u>309</u> Well depth: <u>309</u> Well grouted to a depth of <u>10</u> feet					
	Bentonite Mix				
Casing length: <u>294</u> feet Casing diameter: <u>2</u> inches Type of casing: <u>OVC</u>					
Screen length: 5 feet Screen diameter: 2 inches Type of screen: DVC					
Screen slot size: ,004 inches Setting depth: From 294 feet to 309 feet					
Type of completion (circle all applicable): Gravel packed Underreamed Telescoped Open hole Natural Development					
	Other (describe):				
Top of lap pipe or reduction in casing:feet. If telescoped or more than one screen, describe on back of page					
Logs run (circle all applicable) No log ru	n) Electric Gamma Ray	Density Sonic Neutron	Other:		
Name of organization running log(s):	Ucted, and completed in a	accordance with all applicable	requirements of the Mississippi		
I certify that the well was drilled, constructed, and completed in accordance with all applicable requirements of the Mississippi Department of Environmental Quality and/or the Mississippi Department of Health regulations and state laws.					
Jack Ridadell A	-472	(and a	Riberlell		
Print Name of Water Wen Contractor and	License No.	Signature of			
L		U			
		-	AUG 15 2006		

· . ' ,

BY:	OL	.WR
-----	----	-----

A-88

If well telescopes please sketch below and show depths.




۰,

۰.

Description of Formations Encountered TOP SOI Orange Clay BILLE Clay Gray Fine Sand BILLE Clay	
Gray Medlum Sand	

If more than one screen, show location of each on sketch

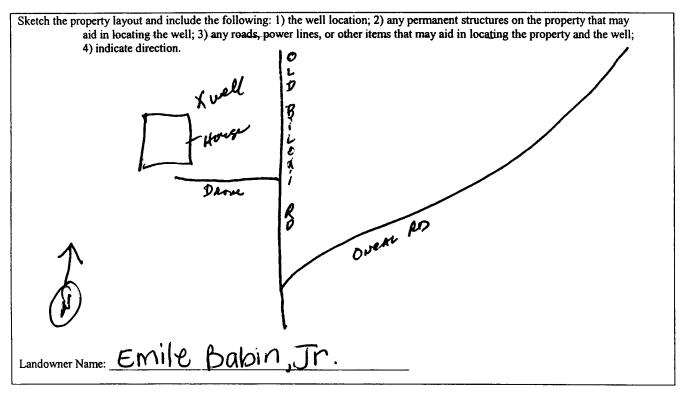

Signature of Water Well Contractor

AUG 1 5 2006 BY: OLWR

STATE WELL REPORT						
County: Jackson	Part 2 Pump Installer's Completion Report Mississippi Department of Environmental Quality Office of Land and Water Resources		For Office Use Only: Aquifer:			
Driller: COAST WATER WENSIV. Date completed: 7-20-04	P.O. Box 10631 Jackson, MS 39289-0631 (601)961-5210 (601)354-6938 (fax)		Well #: <u>A-88</u> Elevation:			
This report should be prepared by the pump installer in detail and filed with the Department within 30 days of the installation of pump.						
Well Owner Information Owner Name: Emile Babin Jr. Mailing Address: DESOTO BLUFFS LOT 13 Vancleave MS 39505 State Zip Code Telephone No. (2008) 3105 - 5974		Well Location Latitude: 30°38'831" Longitude: 088° 49'360" Latitude: 088° 49'360" Method of Lat/Long (circle one): Conventional Survey, USGS quad, Hand-held GPS, Survey-grade GPS SE 1/4 SW 1/4 Sec 2.1 Twn T 4/S Rng R #W Distance Direction Nearest Town 12 Miles NW of				
Air Lift Jet Submersible		Power Type Circle one Diesel Engine Gasoline Engine Natural Gas				
Bucket Piston	Turbine	Electric Motor Hand	Tractor PTO			
Centrifugal Rotary Other (specify): Date Pump Installed:	Flowing Well	Windmill Other Horse Power Rating of Motor Setting Depth: 30 FH. Number of Stages:	NOP PIP Creet			
Pumping Water Level (B): <u>VIA</u> Feet E Drawdown [(B) – (A)]: <u>VIA</u> Feet F	Below Land Surface Gallons Per Minute	Method of Measuring Water Level Circle one Air Line Electric Measuring Line Steel Tape Other (specify):				
I HEREBY CERTIFY that the above statem Ben Bidge ell 0-717 Print Name of Pumpinstaller and License N	3P	of my knowledge. <u>B. R.</u> Signature of Pump In	Igdu Maller RECEIVEL			

хτ ',

AUG 1 5 2006 BY: OLW R