	State Well Report				
county Jackson	Part 1	For Office Use Only:			
	ppi Department of Environmenta	Quality Aquifer:			
	office of Land and Water Resourc P.O. Box 10631	es Well #: <u>A-92</u>			
Driller: COCIST WATER WELLSRV.	Jackson, MS 39289-0631	L. S. Elevation:			
Date drilling completed:3-010	(601)961-5210 (601)354-6938 (fax)	E-log #:			
State Law requires that this report be pr 30 days of completion of drilling of the w	epared by the driller in detail a	nd filed with the Department within			
Well Owner Information		Well Location			
Owner Name L. DEAN FAULK	Latitude: <u>30 • 1</u>	<u>13'123</u> " Longitude: <u>088° 44' 408</u> " 24			
Mailing Address: HWY 57	Method of Lat/Lor	ng (circle one): Conventional Survey,			
		Hand-held GPS, Survey-grade GPS			
Vancleave Ms 3 City State	<u>89565</u> <u>N/w 1/2 1/2 1/2 1/2 1/2 1/2 1/2 1/2 1/2 1/2</u>	Sec_12Twn_T45_Rng_R8W			
Telephone No. ()	Distance I Miles	Direction Nearest Town N of VANCLEAVE			
	Well Data				
Purpose of Well (circle one) Home Industrial	Public Supply Irrigation Fish	Culture Other:			
Date well drilling started:	$\square \Lambda$				
If flowing, method of flow regulation: Valve 14 Other (describe)					
Static Water Level:feet above of be	ow circle one) land surface Date	measured:3-DQ			
Method of Measurement (circle one) steel tape electric tape air line other:					
Hole depth: Well depth: Well grouted to a depth of feet					
Type of grout (circle one): Cement Benton	ite) Mix				
Casing length: 100 feet Casing diameter: 2 inches Type of casing: 0VC					
Screen length:					
Type of completion (circle all applicable): Gravel p	acked Underreamed Telescope	d Open hole Natural Development			
Other (describe):					
Top of lap pipe or reduction in casing:feet. If telescoped or more than one screen, describe on back of page					
Logs run (circle all applicable). No log run Electric Gamma Ray Density Sonic Neutron Other:					
Name of organization running log(s) NIA					
I certify that the well was drilled, constructed, and completed in accordance with all applicable requirements of the Mississippi					
Department of Environmental Quality and/or the	Mississippi Department of Health r	regulations and state laws.			
Jack Ridgdell D-L	na	Jun Rel ABERENIE			
Print Name of Water Well Contractor and License No	ssi	Endeture of Water Well Contractor			
		BY: OLW			


A-92

If well telescopes please sketch below and show depths.

Ground Level

Description of Formations Encountered	From	То
 TOP SOIL White coarse sand Blue clay Law med. to med. Sand	0 3 15 70	25720

If more than one screen, show location of each on sketch

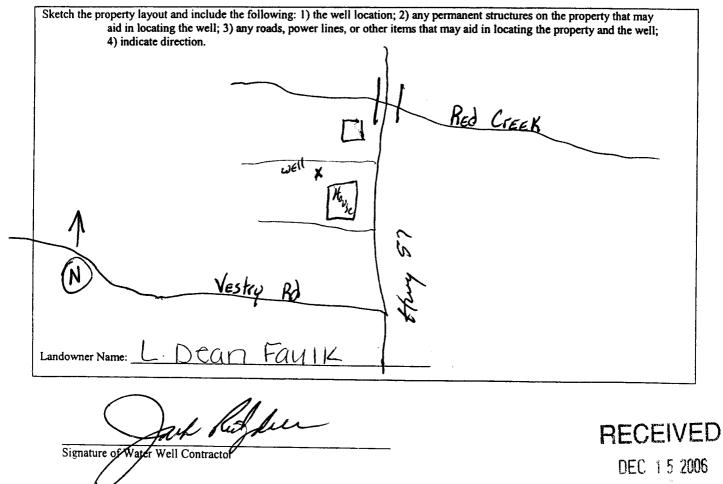

BY: OLWR

STATE WELL REPORT						
County: <u>JACKSON</u> Permit #: Driller: <u>COASE WATER WEI</u> ISR. Date completed: <u>11-13-00</u>	Part 2 Pump Installer's Completion Report Mississippi Department of Environmental Quality Office of Land and Water Resources P.O. Box 10631 Jackson, MS 39289-0631 (601)961-5210 (601)354-6938 (fax)		For Office Use Only: Aquifer: Well #: A-9 2 Elevation:			
This report should be prepared by the pump installer in detail and filed with the Department within 30 days of the						
installation of pump. Well Owner Informati	ion	Well	Location			
Owner Name: L. Dean Fal	114	Latitude: <u>30°4.3'12.3''</u> Longitude: <u>088°44'408</u> °				
Mailing Address: <u><u><u></u><u></u><u><u></u><u><u></u><u></u><u><u></u><u></u><u><u></u><u></u><u></u><u><u></u><u></u><u></u><u></u><u></u><u></u></u></u></u></u></u></u></u>	ailing Address: <u>HWY·57</u>		Method of Lat/Long (circle one): Conventional Survey, USGS quad, (Hand-held GPS, Survey-grade GPS			
Vancleave MS 39565 City State Zip Code		$\underline{N}\omega$ $\frac{1}{2}$ $\underline{N}\varepsilon$ $\frac{1}{2}$ $\underline{N}\omega$ $\underline{N}\varepsilon$				
Telephone No. (228)	Telephone No. (228)		12 Miles N of VANCLEAVE			
· · · · · · · · · · · · · · · · · · ·						
Pump Type Circle one		Power Type Circle one				
Air Lift Jet	Submersible		e Engine Natural Gas			
Bucket Piston	Turbine	Electric Motor Hand	Tractor PTO			
Centrifugal Rotary	Flowing Well		pecify):			
Other (specify):		Horse Power Rating of Motor:	-			
Date Pump Installed: 11-14-06 Setting Depth: 40 Ft drop pipe feet						
Rated Pump Capacity:8	Gallons Per Minute	Number of Stages: 2				
Pump Test Data	Dump Tast Data					
Date Well Tested: $1 - 14 - 060$			suring Water Level cle one			
		Air Line Electric Measu	uring Line Steel Tape			
Pumping Water Level (B): <u>NA</u> Feet B	Other (specify):					
Drawdown [(B) - (A)]: N/A Feet B	elow Land Surface	For flowing well, measured shu	t in head: <u>N/A</u> feet			
Test Pumping Rate: 8	Gallons Per Minute	Well yielded GPM with a drawdown of				
Duration of Pump Test (minimum 4 hours): <u>4</u> hours <u>NIA</u> feet after <u>NIA</u> hours of pumping						
HEREBY CERTIFY that the above statements are true to the best of my knowledge 1						
John Elkins O-716P The PRECEIVED						
Print Name of Pump Installer and License No. (if applicable) Signature of Pump Installer DEC 1 5 2006						

BY: OLWF