	State W	ell Report	
County: Jackson	P	art 1	For Office Use Only:
		t of Environmental Quality and Water Resources	Aquifer:
Permit #:		Box 10631	Well #:
Driller: UUST WUTEL WAISN	(·	IS 39289-0631	L. S. Elevation:
Date drilling completed: 7-20-09		961-5210 54-6938 (fax)	E-log #:
State Law requires that this rep 30 days of completion of drilling	ort be prepared by the g of the well.		
Well Owner Inform	ation		Location
Owner NameScott McLa	llen	Latitude: <u>30 • 40 '373</u>	3' Longitude 088 · 48 · 106.
Mailing Address: Wire P	<u>Z.</u>	Method of Lat/Long (circle or	ne): Conventional Survey,
		USGS quad, Hand-held	GPS Survey-grade GPS
Vancleave	MS 39565	SE 1/ 10 1/2 Sec 28	29 Twn T4 5 Rng R8 W
City Sta		NE NE Distance/ Direction	Nearest Town
Telephone No. 20 217-6	093	Distance Direction	of VAncleave
	Well	Landon Data	
Purpose of Well (circle one Home Inc	lustrial Public Supply	Irrigation Fish Culture	Other:
Date well drilling started: 7-20	-09 Date v	vell drilling completed:	1-20-09
If flowing, method of flow regulation: Va			
Static Water Level: 136 feet al	-		
	\bigcirc	air line other:	
Hole depth: <u>282 FT</u> . Well de		\smile	_
		well grouted to a depth of	<u> </u>
Type of grout (circle one): Cement			out
. 6	_	inches Type of casing:	
Screen length:feet Scre	en diameter:	inches Type of screen:	<u>P.VC</u>
Screen slot size: • CCC inches	Setting depth: From _	<u>272</u> feet to <u>2</u>	82 feet
Type of completion (circle all applicable):	Gravel packed Under	reamed Telescoped Open	hole Natural Development
	Other (describe):		
Top of lap pipe or reduction in casing: _	N/A feet. If te	escoped or more than one scre	een, describe on back of page
Logs run (circle all applicable). No log ru	n) Electric Gamma Ray	Density Sonic Neutron	Other:
Name of organization running log(s):	NA		
I certify that the well was drilled, constr	-		•
Department of Environmental Quality a	and/or the Mississippi De	partment of Health regulations	s and state laws.
Jack Kidgdel 0.	-472-	Jait the	Aduce
Print Name of Water Well Contractor and	License No.	Signature of	

•, •

۰

AUG 1 2 2009

BY: OLWR

ALRS

...


To

If well telescopes please sketch below and show depths.

Ground Level

vel	Description of Formations Encountered	From To		
	TOPSOIL	02		
	Prown. Coarse Sand	a 40		
)	Blue Clay	4026		
		27120		
	Gray meau un Sala			
	······································			
	······································			
	······································			

If more than one screen, show location of each on sketch

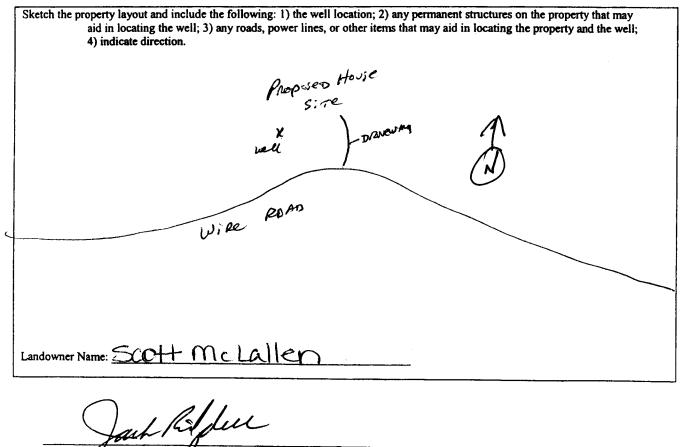

Signature of Water Well Contractor

AUG 1 2 2009

RECEIVED

BY: OLWR

		ELL REPORT	
County: Jackson Permit #:	Part 2 Pump Installer's Completion Report Mississippi Department of Environmental Quality Office of Land and Water Resources P.O. Box 10631 Jackson, MS 39289-0631 (601) 961-5210 (601) 354-6938 (fax)		For Office Use Only: Aquifer: Well #: <u>A 128</u>
Driller: <u>USTWITG</u> WEISKV. Date completed: <u>7-30-07</u>			Well #:
This report should be prepared by the) he pump installer in det	ail and filed with the Departme	nt within 30 days of the
installation of pump. Well Owner Informat	tion	Well	Location
Owner Names Scott McLallan		Latitude: 30°40' 373" Longitude: 088°48'106	
Mailing Address: Wire Rd.		Method of Lat/Long (circle one): Conventional Survey,	
		USGS quad Hand	held GPS) Survey-grade GPS
Vancleave (City State	Ns 39565 Zip Code	Distance Direction	
Telephone No. 28 217-60	13	<u><u><u> </u></u></u>	Varileave
Pump Type		Pov	ver Type
Circle one			rcle one
Air Lift	Submersible	Diesel Engine Gasoline	e Engine Natural Gas
Bucket Piston	Turbine (Electric Motor Hand	Tractor PTO
Centrifugal Rotary	Flowing Well		specify):
Other (specify):		Horse Power Rating of Motor:	a Hr
Date Pump Installed:	9	Setting Depth: 160PT	.Droffleteet
Rated Pump Capacity: <u>5.</u>	Gallons Per Minute	Number of Stages:	3
Pump Test Data			suring Water Level rcle one
Date Well Tested: <u>7-27-09</u>		Air Line Electric Meas	uring Line Steel Tape
11/0	Below Land Surface		
	Below Land Surface		
Drawdown [(B) – (A)]: $\underline{N/A}$ Feet	Below Land Surface	For flowing well, measured shu	/
Test Pumping Rate: 5	- -	Well yielded 2	
Duration of Pump Test (minimum 4 hours):	hours	N/A feet after	NA hours of purnping
HEREBY CERTIFY that the above statem	hents are true to the best o	it my knowledge.	ffere perce
Print Name of Pump Installer and License N	lo. (if applicable)	Signature of Pump Ins	
		V	AUG 12
			BY: O

• • •

.