State W	ell Report			
P	art 1	For Office Use Only:		
Mississippi Department	t of Environmental Quality nd Water Resources	Aquifer: 146		
	lox 10631	Well #:		
Jackson, M	IS 39289-0631	L. S. Elevation:		
	961-5210 4-6938 (fax)	E-log #:		
State Law requires that this report be prepared by the 30 days of completion of drilling of the well.	driller in detail and filed w	ith the Department within		
Well Owner Information	well Lo			
Owner Name Michael + Joshlette Othern	01/11 Latitude: 30. 11 . H. 96" Longitude: 088. 45, 26.7			
Mailing Address:Bilbo Rd	Method of Lat/Long (circle on	e): Conventional Survey,		
		GPS, Survey-grade GPS		
Vanckave, Ms 39565	NW 1/4 NG 1/4 Sec 26	Twn T45 Rng R8W		
City State Zip Code Telephone No. 2018) 381-0007	Distance Direction	Nearest Town of Vancleave		
Well D	)ata			
		01		
Purpose of Well (circle one) Home Industrial Public Supply Irrigation Fish Culture Other:				
Date well drilling started: $(0/5/12)$ Date well drilling completed: $(0/5/12)$				
If flowing, method of flow regulation: Valve $N/A$ Other (de				
Static Water Level: <u>45</u> feet above or below (circle one) la	and surface Date measured:	6/5/12		
Method of Measurement (circle one) steel tape electric tape air line other:				
Hole depth: <u>LOOFT</u> Well depth: <u>ICOFT</u> Well grouted to a depth of <u>IO</u> feet				
Type of grout (circle one): Cement Bentonite Mix				
Casing length: <u>90</u> feet Casing diameter: <u>a</u> inches Type of casing: <u>PVC</u>				
Screen length: 10feet Screen diameter: 2inches Type of screen: PVC				
Screen slot size:	<u>90</u> feet to <u>10</u>	DC feet		
Type of completion (circle all applicable): Gravel packed Underreamed Telescoped Open hole Natural Development				
Other (describe):				
Top of lap pipe or reduction in casing: <u>NA</u> feet. If telescoped or more than one screen, describe on back of page				
Logs run (circle all applicable): No log run Electric Gamma Ray Density Sonic Neutron Other:				
Name of organization running log(s): N/A I certify that the well was drilled, constructed, and completed in accordance with all applicable requirements of the Mississippi				
Department of Environmental Quality and/or the Mississippi Department of Health regulations and state laws.				
Jock Ridgdell D-475				
Print Name of Water Well Contractor and License No. RECE	VED Signature of V	Water Well Contractor		
JUN 2 0 2012 Lewis Printing - Pascagoula, MS				
BY: OLWR				


.

If well telescopes please sketch below and show depths.

Ground Level

 Description of Formations Encountered TOP SOIL Orange Clay Orange Clay Orange Clay Due Clay	From To Q Q J 15 Is 20 J2 35 35 70
Orange Coarse Sand	70 100

If more than one screen, show location of each on sketch

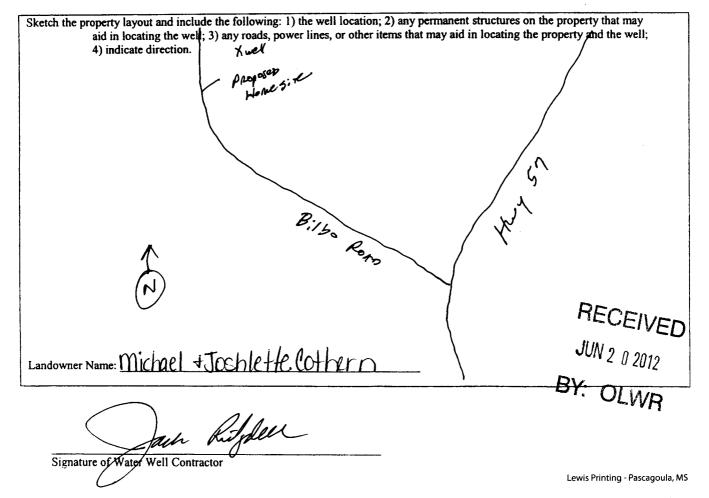

A146

STATE WELL REPORT					
County: Jackson M Permit #: Driller: Date Water Wellsky, Date completed: <u>Le15/12</u>	Part 2 Pump Installer's Completion Report Mississippi Department of Environmental Quality Office of Land and Water Resources P.O. Box 10631 Jackson, MS 39289-0631 (601) 961-5210 (601) 354-6938 (fax)		For Office Use Only:    Aquifer:		
This report should be prepared by the pu installation of pump.	This report should be prepared by the pump installer in detail and filed with the Department within 30 days of the				
Well Owner Information	tion		Location		
Owner Name: Michael + Joshleth			Longitude: <u>088°45'26.76</u> "		
Mailing Address: Bilbo Rd		Method of Lat/Long (circle on	ong (circle one): Conventional Survey,		
	USGS		quad, Hand-held GPS, Survey-grade GPS		
Vancleave, Ms City State	<u>NS 39565</u> Zip Code <u>NW 1/2 NE 1/2 Sec 2</u> Distance Direction				
Pump Type Circle one			wer Type ircle one		
Air Lift Jet Su	bmersible	Diesel Engine Gasolin	e Engine Natural Gas		
Bucket Piston Tu	rbine	Electric Motor Hand	Tractor PTO		
Centrifugal Rotary Fl	owing Well	Windmill Other (	specify):		
Other (specify):	Horse Power Rating of				
Date Pump Installed: 6/6/12	2 Setting Depth: (pOFT)		OPPiPC feet		
Rated Pump Capacity: Gal	lons Per Minute	Number of Stages:			
Pump Test Data		Mathed of Measuring Water Level			
Date Well Tested: 66612		Method of Measuring Water Level Circle one			
1F			Air Line Electric Measuring Line Steel Tape		
( <b>1</b> ,	Other (specify):				
	ow Land Surface	For flowing well, measured shut in head:			
Test Pumping Rate: Gall	Gallons Per Minute Well yielded GPM with a drawdown of		GPM with a drawdown of		
Duration of Pump Test (minimum 4 hours):	<u> </u>	NA feet after	NA hours of pumping		
I HEREBY CERTIFY that the above statements are true to the best of my knowledge. Jack Ridgdell 0-472 Print Name of Pump Installer and License No. (if applicable) JUN 2 0 2012 in the pump Installer BV: 01 W/P					
BY: OLWR					

• • •