

MISSISSIPPI DEPARTMENT OF NATURAL RESOURCES
Bureau of Land and Water Resources
 Southport Mall
 P.O. Box 10631
 Jackson, Mississippi 39209
WATER WELL DRILLERS LOG

Jackson
A 2011

5-9-1986 date well completed Sto Pierce Mulling Co. firm name Jackson county well located

LANDOWNER: Anthony Kates
20317 Old Belopri
Dean Springs, Ms
 (mailing address)

description of formations encountered	from	to
<u>top soil</u>	<u>0</u>	<u>10</u>
<u>clay</u>	<u>10</u>	<u>250</u>
<u>good sand</u>	<u>250</u>	<u>270</u>

WELL LOCATION:
 sec 34 T 7 N R 8 E
10 miles South of Deary Heaty
 (distance) (direction) (nearest town)

WELL PURPOSE:
 (home) irrigation, municipal, industrial

- WELL COMPLETION DATA:
- (1) diameter (inches) 2"
 - (2) total depth (feet) 270'
 - (3) static water level (feet) 56' below above top of ground.
 - (4) casing plastic, 260'
 (material) (depth)
 - 0 if telescope see back.
 (size)
 - (5) screen 10', 270'
 (length) (depth to top)
 - 006, plastic
 (size) (material)
 - (6) pump 1 8
 (HP) (yield gpm)
 - electric
 (type power)
 - (7) electric log yes (yes or no)

(8) how well bottom plugged BW
 (organization running log)


DRILLERS REMARKS:

RECEIVED
 MAY 14 1986

Department of Natural Resources
 Bureau of Land & Water Resources

If well telescopes please sketch and show depths.

GROUND LEVEL

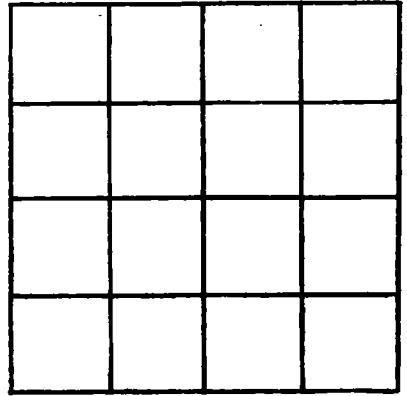

SECTION _____

Please indicate well location X.

ADDITIONAL INFORMATION

If more than one screen, show locations of each on sketch.