

MISSISSIPPI DEPARTMENT OF NATURAL RESOURCES
Bureau of Land and Water Resources

P.O. Box 10631
Jackson, Mississippi 39209
WATER WELL DRILLERS LOG

COUNTY WELL LOCATED JACKSON	
WELL NUMBER A 2013	CODED
DATE WELL COMPLETED 3 JAN 88	

PERMIT NUMBER 0-485
NAME OF DRILLING FIRM CORETEC

NAME & MAILING ADDRESS OF LANDOWNER JIMMY DESPORT 3/6 Biloxi Paper Co. 1216 EAST DIVISION ST Biloxi, Ms.		
WELL LOCATION: SEC	TOWNSHIP	RANGE
10	4	9
DISTANCE	DIRECTION	NEAREST TOWN
26 Miles	NORTH	Biloxi
OTHER LANDMARK INTERSECTION WIRE ROAD AND DANCE AREA Rd		
WELL PURPOSE: Home, Irrigation, Municipal, Industrial, Fish Pond, etc. HUNTING CAMP		

PUMP DATA		
PUMP TYPE (Circle One): Submersible, Turbine, Jet Flowing Well, Other (Describe) _____		
POWER TYPE (Circle One): Electric , Tractor, Diesel, Gasoline, Butane, Other (Describe) _____		
Pump Capacity (GPM) 20	No. of Stages 2	Setting Depth 140' NET FT.
PUMP TEST Well yielded 14 GPM with drawdown of 65' ft. after 2 hours of pumping		

WELL DATA		
Well Depth 163'	Casing Diameter (In.) 2"	Casing Length (Ft.) 153'
Type of Casing PVC	Hole Depth 168'	Depth to Static Water Level 55'
TYPE OF COMPLETION: (Circle One or More): Natural Development , Gravel Packed, Underreamed, Telescoped, Open Hole, Other (Describe) _____		
Top of Lap Pipe or Reduction in Casing N/A FEET		
IF TELESCOPED OR MORE THAN ONE SCREEN: USE BACK PAGE		

LOG DATA	
TYPE OF LOG RUN (Circle One): Electric, Gamma Ray, Density, Sonic, No Log Run , Neutron, Other (Describe) _____	
Name of Organization Running Log	

SCREEN DATA		
Diameter - Inches 2"	Length - Feet 10'	Slot Size - Inches 8
Screen Type COT PVC	Depth to Bottom - Feet 153'-163'	


GEOLOGIC DATA (Office Use Only)			
Surface Elev.	Geologic Unit	Unit Thickness	Depth to Top
Subs. SWL	Date	Analysis	Aquifer Test
Driller's Remarks TRIED TO DEVELOPE SAND AT 47'-67', WOULD NOT DEVELOPE SATISFACTORILY			

DESCRIPTION OF FORMATIONS ENCOUNTERED	FROM	TO
TOP Soil	0	2
YELLOW SANDY CLAY	3	12
WHITE SUGAR SAND	12	16
GRAY POTTERY CLAY	16	38
BLUE MUD + SHELL FRAG	38	46
GRAY COURSE SAND	47	67
BLUE MUD + SHELL FRAG	68	105
FINE SAND - GRAY	106	112
BLUE GUMBO MUD	113	146
COURSE SALT + PEPPER SAND	147	165
BLUE GUMBO MUD	166	-

RECEIVED	
FEB 26 1988	
Department of Natural Resources Bureau of Land & Water Resources	
IF MORE SPACE IS NEEDED, USE BACK	

If well telescopes please
sketch and show depths.

GROUND LEVEL

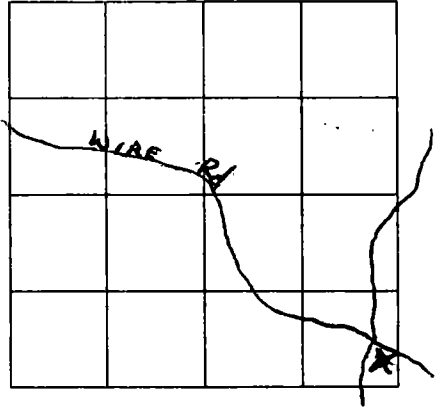

SECTION 10

Please indicate well location X.

ADDITIONAL INFORMATION

Lined area for additional information.

If more than one screen,
show location of each on sketch.