

**MISSISSIPPI DEPARTMENT OF NATURAL RESOURCES**  
Bureau of Land and Water Resources

P.O. Box 10631

Jackson, Mississippi 39209

**WATER WELL DRILLERS LOG**

COUNTY WELL LOCATED  
**JACKSON**

WELL NUMBER CODED  
**A 2014**

DATE WELL COMPLETED  
**5/4/88**

PERMIT NUMBER  
**408**

NAME OF DRILLING FIRM  
**Fry Eagle Waterwell  
LUCEDALE, MS**

NAME & MAILING ADDRESS OF LANDOWNER  
**JERRY LOTT  
4618 Robinhood Dr.  
Pascagoula, MS**

WELL LOCATION: SEC TOWNSHIP RANGE  
**South 4 T4 S1 R8 E**

DISTANCE DIRECTION NEAREST TOWN  
**2 1/2 Miles South of McLean**

OTHER LANDMARK  
**Close to old Bencheen Saw mill**

WELL PURPOSE: Home, Irrigation, Municipal, Industrial, Fish Pond, etc.  
**Comp.**

**PUMP DATA**

PUMP TYPE (Circle One):  
Submersible, Turbine, **Jet** Flowing Well,  
Other (Describe) \_\_\_\_\_

POWER TYPE (Circle One):  
**Electric** Tractor, Diesel, Gasoline, Butane,  
Other (Describe) \_\_\_\_\_

Pump Capacity (GPM)	No. of Stages	Setting Depth
<b>10</b>	<b>1</b>	<b>30'</b>

FT.

PUMP TEST

Well yielded **8** GPM with  
a drawdown of **Stallou well Ref. #**  
after **2** hours of pumping

**WELL DATA**

Well Depth <b>46' 45"</b>	Casing Diameter (In.) <b>2</b>	Casing Length (Ft.) <del>580</del>
Type of Casing <b>PVC</b>	Hole Depth <b>580'</b>	Depth to Static Water Level <b>20'</b>

TYPE OF COMPLETION: (Circle One or More):  
Gravel Packed, Underreamed, Telescoped,  
**Natural Development**, Open Hole, Other

Top of Lap Pipe or Reduction in Casing

FEET IF TELESCOPED OR MORE THAN ONE SCREEN: USE BACK PAGE

**LOG DATA**

TYPE OF LOG RUN (Circle One):  
No Log Run, Electric, Gamma Ray, Density, Sonic, Neutron,  
Other (Describe) \_\_\_\_\_

Name of Organization Running Log

**SCREEN DATA**

Diameter - Inches <b>1 1/4"</b>	Length - Feet <b>5'</b>	Slot Size - Inches <b>#6</b>
Screen Type <b>PVC</b>	Screen Material <b>Sawal</b>	Depth to Bottom - Feet <b>46' 45"</b>

**GEOLOGIC DATA (Office Use Only)**

Surface Elev.	Geologic Unit	Unit Thickness	Depth to Top
Subs. SWL	Drill	Analysis	Augular Test

Driller's Remarks

**RECEIVED**

**JUL 01 1988**


Department of Natural Resources  
Bureau of Land & Water Resources

DESCRIPTION OF FORMATIONS ENCOUNTERED	FROM	TO	FORMATIONS (Continued)	FROM	TO
<b>Top Soil</b>	<b>0</b>	<b>5</b>			
<b>Sand</b>	<b>5</b>	<b>20</b>			
<b>Clay</b>	<b>20</b>	<b>40</b>			
<b>Sand</b>	<b>40</b>	<b>46</b>	<b>set Screen</b>		
<b>Clay</b>	<b>46</b>	<b>120</b>			
<b>Clay</b>	<b>120</b>	<b>300</b>			
<b>Clay</b>	<b>300</b>	<b>480</b>			
<b>Clay</b>	<b>480</b>	<b>550</b>			
<b>Silt</b>	<b>550</b>	<b>580</b>			

IF MORE SPACE IS NEEDED, USE BACK

If well telescopes please sketch and show depths.

GROUND LEVEL

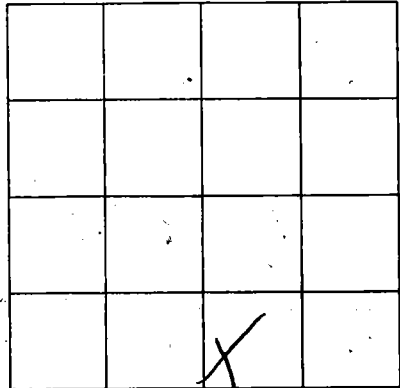

SECTION 36

Please indicate well location X.

ADDITIONAL INFORMATION

Lined area for additional information.

If more than one screen, show location of each on sketch.